

"I, MARK SHAW being a certified / registered engineer and duly authorised representative of KN GROUP PTY LTD hereby -

- × Certify the information contained in this drawing is an accurate "AS CONSTRUCTED" representation of the works.
- × Accept responsibility for the "AS CONSTRUCTED" information contained in this drawing.
- × Acknowledge the "AS CONSTRUCTED" information contained in the drawing may be relied on by Council and others.


Certification for Stage ..... by ..... on .....

for KN GROUP PTY LTD.


Registered Professional Engineer of Queensland - No. 17544

We RPS Australia East Pty Ltd, Registered Surveyor - Land hereby certify that the Levels and Dimensions shown hereon are a correct record of our Survey which was performed in accordance with Council Accuracy Standards

Authorised Delegate ..... Date .....

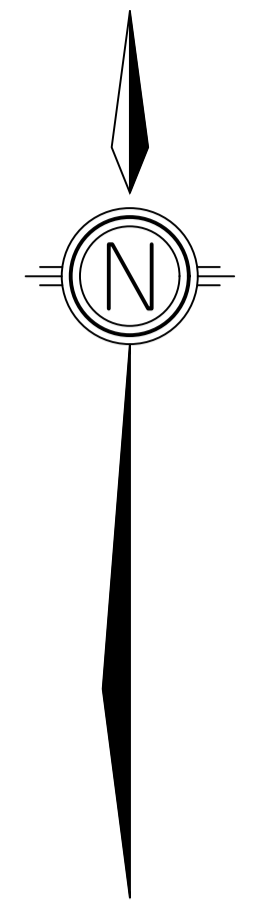

NOTES:  
 All Stormwater Pipes Are Class '2' RC Pipes Unless Noted Otherwise  
 Year Of Construction 2016

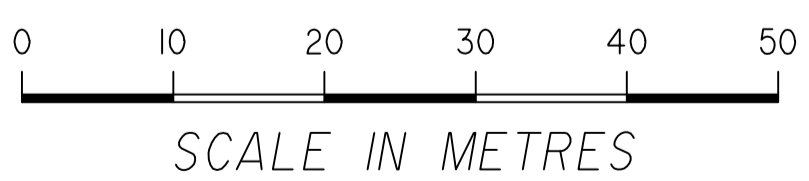

PROJECT <b>NORTH HARBOUR</b>		CLIENT <b>NORTHEAST BUSINESS PARK</b>	
LEVEL DATUM AHD	SCALE <b>1:500 @ A1</b>	 RPS Australia East Pty Ltd ACN 140 292 762 ABN 44 140 292 762 743 Ann Street PO Box 1659 Fortitude Valley QLD 4006 T +61 7 3237 8899 F +61 7 3237 8833 W rpsgroup.com.au	
ORIGIN PM 72418 RL 14-859 CNR BUCKLEY & COBB RDS	Date: JUNE 2017 Surveyed: RPS Comp by: AJH		
FB : SDR	LB :	DWG Name: 20430-Stage13A-Pos	Local Authority: MORETON BAY REGIONAL COUNCIL
Parish: REDCLIFFE		Job Ref: 20430-SI3A	Reference: <b>20430-195</b>
			Rev