

"I, MARK SHAW being a certified / registered engineer and duly authorised representative of KN GROUP PTY LTD hereby -

- × Certify the information contained in this drawing is an accurate "AS CONSTRUCTED" representation of the works.
- × Accept responsibility for the "AS CONSTRUCTED" information contained in this drawing.
- × Acknowledge the "AS CONSTRUCTED" information contained in the drawing may be relied on by Council and others.

Certification for Stage by on

for KN GROUP PTY LTD.


Registered Professional Engineer of Queensland - No. 17544

We RPS Australia East Pty Ltd, Registered Surveyor - Land hereby certify that the Levels and Dimensions shown hereon are a correct record of our Survey which was performed in accordance with Council Accuracy Standards

[Signature]

Authorised Delegate

13/09/2017
Date

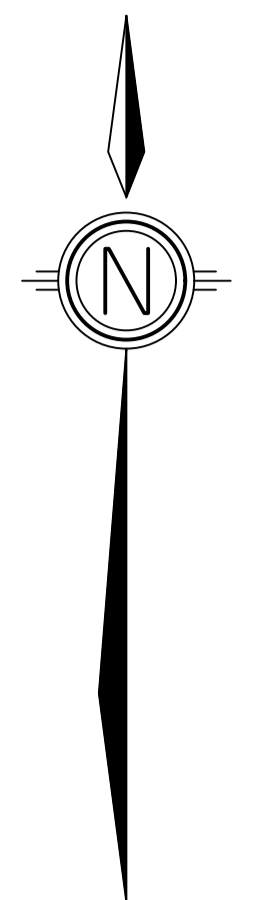

LEGEND	
	Existing #150 Water Main
	150# Water Main
	Water Conduit
	Water Service Pipe


TABLE OF FITTINGS	
ITEM #	DESCRIPTION
1	150# * 150# TEE
2	HYDRANT
3	TEMPORARY HYDRANT/END
4	WATER METER
5	READYTAP
6	150# VALVE

Water Mains at Road Crossings are uPVC Class 20.

A1

INDEX	DATE	REVISIONS	DRAWN	CHECKED	PASSED
A	2017	ORIGINAL ISSUE	RPS	RPS	-

DRAWN	CHECKED	PASSED	INITIALS	DATE
A.JH	A.JH	-	-	2017
-	-	-	-	-

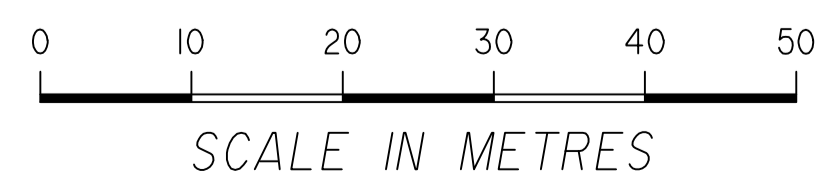

Unitywater

NORTHEAST BUSINESS PARK C/- KN GROUP PTY LTD CONSULTING ENGINEERS
NORTH HARBOUR - STAGE 16
AS CONSTRUCTED WATER RETICULATION

SCALE	1500 at A1
SHEET	1 OF 1 SHEETS
DRAWING NO-	20430-203