

LEGEND

- Post Construction Contours
- Topographic Change In Grade
- Post Construction Surface Level
- Concrete Path or Driveway
- Edge of Bitumen

"I, MARK SHAW being a certified / registered engineer and duly authorised representative of KN GROUP PTY LTD hereby -

- × Certify the information contained in this drawing is an accurate "AS CONSTRUCTED" representation of the works.
- × Accept responsibility for the "AS CONSTRUCTED" information contained in this drawing.
- × Acknowledge the "AS CONSTRUCTED" information contained in the drawing may be relied on by Council and others.

Certification for Stage by on

for KN GROUP PTY LTD.
Registered Professional Engineer of Queensland - No. 17544

We RPS Australia East Pty Ltd, Registered Surveyor - Land hereby certify that the Levels and Dimensions shown hereon are a correct record of our Survey, which was performed in accordance with Council Accuracy Standards

2/11/2017
Authorised Delegate Date

Surface Type: AC
Surface Thickness: 25mm
Base Type: GR21
Base Depth: 100mm
SubBase Type: GR23
SubBase Depth: 150mm
CBR6

Footpath
(W)1500mm x (D)125mm


Surface Type: AC
Surface Thickness: 25mm
Base Type: GR21
Base Depth: 100mm
SubBase Type: GR23
SubBase Depth: 150mm
CBR6

Footpath
(W)1500mm x (D)125mm

Surface Type: Concrete
Surface Thickness: 25mm
Base Type: GR21
Base Depth: 100mm
SubBase Type: GR23
SubBase Depth: 200mm
CBR9

Surface Type: Concrete
Surface Thickness: 175mm
SubBase Type: GR23
SubBase Depth: 200mm
CBR9

Surface Type: AC
Surface Thickness: 25mm
Base Type: GR21
Base Depth: 100mm
SubBase Type: GR23
SubBase Depth: 100mm
CBR9

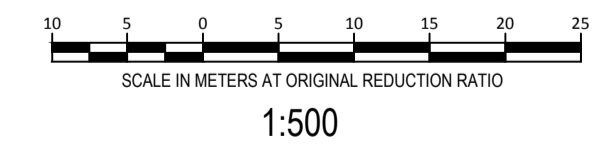

PROJECT NORTH HARBOUR		CLIENT NORTHEAST BUSINESS PARK	
LEVEL DATUM AHD	SCALE 1:500 @ A1	AS - CONSTRUCTED POST CONSTRUCTION CONTOURS STAGE 15	
ORIGIN PM 72418 RL 14.859 CNR BUCKLEY & COBB RDS	Date: OCT 2017 Surveyed: RPS Comp by: KCH		
FB : SDR	LB :	DWG: 20430-Stage15-Post	Parish: REDCLIFFE Local Authority: MORETON BAY REGIONAL COUNCIL
		Job Ref 20430	Rev

RPS

RPS Australia East Pty Ltd
ACN 140 292 762
ABN 44 140 292 762
743 Ann Street
PO Box 1559
Fortitude Valley QLD 4006
T +61 7 3237 8899
F +61 7 3237 8833
W rpsgroup.com.au

© COPYRIGHT PROTECTS THIS PLAN
Unauthorized reproduction or amendment
not permitted. Please contact the author.

Reference
20430-210