

NOTES

- All Sewer Main Pipes are Ø160 PE21 PE100 Class SDR21, Unless noted otherwise.
- All Sewer House Connections are Ø110 PE, Unless noted otherwise.

MORNINGTON PARADE

ORPHEUS STREET

NORFOLK DRIVE

NORFOLK DRIVE

DRIVE

MORETON BAY BOULEVARD


AS CONSTRUCTED

ENGINEER'S CERTIFICATION

I, MARK SHAW, being a certified / registered engineer and duly authorised representative of KN GROUP PTY LTD hereby:
 - Certify the information contained in the drawing is an accurate "AS CONSTRUCTED" representation of the works.
 - Accept responsibility for the "AS CONSTRUCTED" information contained in this drawing.
 - Acknowledge the "AS CONSTRUCTED" information contained in drawing may be relied on by Council and others.
 Certification by _____ on _____
 for KN GROUP PTY LTD.
 Registered Professional Engineer of Queensland - No. 17544

SURVEYOR'S CERTIFICATION

We T.H. JENSEN BOWERS PTY LTD, hereby certify that the vertical and horizontal locations and dimensions shown on this plan are a true and correct record and were located by survey.
 Director _____ Date: 20/02/2019

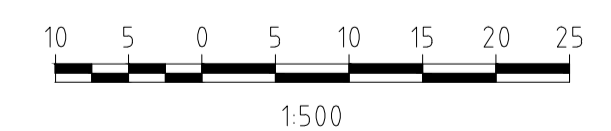

A1

INDEX	DATE	REVISIONS	DRAWN	CHECKED	PASSED	INITIALS	DATE
A	30/01/19	Original Issue	LB	JM			

DRAWN	LB	30/01/19
CHECKED	JM	20/02/19
PASSED		



SURVEYORS PLANNERS DEVELOPMENT ADVISORS
 jensenbowers.com.au
 72 Coolin Street, Fortitude Valley, Qld. 4006
 PO Box 776, Spring Hill, Qld. 4004
 T (07) 3852 1771 F (07) 3252 9818
 T.H. Jensen & Bowers Pty. Ltd. (Consulting Surveyors)
 ABN 52 010 872 807
 ©Copyright reserved to Jensen Bowers Group Consultants Pty Ltd



Unitywater

NORTHEAST BUSINESS PARK C / - KN GROUP PTY LTD CONSULTING ENGINEERS
 NORTH HARBOUR - STAGE 17
 AS CONSTRUCTED SEWER RETICULATION

SHEET 1 OF 1	SHEETS	SCALE 1:500
REVISION DATE	30/01/19	REVISION A
DISCIPLINE CODE		
DRAWING NO.	U-2018-0721	