

LEGEND

- ∅ Pipe Diameter
- Fire Hydrant
- Temporary Hydrant/End
- ⊗ Valve
- ① 11.25° BEND
- ② 22.5° BEND
- ③ 45° BEND
- ④ 90° BEND
- Ready Tap
- Water Meter
- C — Water Crossing
- Water Main
- ▬▬▬ DICT Water Main

NOTES

- Water main pipes are Ø150 PVC-0 Class PN16 unless noted otherwise.
- All road crossings are Ø150 DICT Class DN35.



ENGINEER'S CERTIFICATION

I, MARK SHAW being a certified / registered engineer and duly authorised representative of KN GROUP PTY LTD hereby:

- Certify the information contained in the drawing is an accurate "AS CONSTRUCTED" representation of the works.

- Accept responsibility for the "AS CONSTRUCTED" information contained in this drawing.

- Acknowledge the "AS CONSTRUCTED" information contained in drawing may be relied on by Council and others.

Certification by _____ on _____


For KN GROUP PTY LTD
Registered Professional Engineer of Queensland - No. 17544

SURVEYOR'S CERTIFICATION

We T.H. JENSEN BOWERS PTY LTD, hereby certify that the vertical and horizontal locations and dimensions shown on this plan are a true and correct record and were located by survey.

Director _____ Date: 20/02/2019

AS CONSTRUCTED

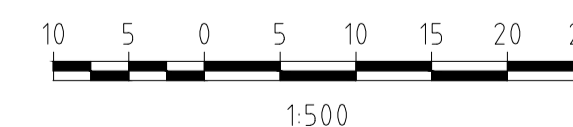

A1

INDEX	DATE	REVISIONS
A	30/01/19	Original Issue

DRAWN	LB	30/01/19
CHECKED	JM	20/02/19
PASSED		

INITIALS	DATE

JENSEN BOWERS
SURVEYORS PLANNERS DEVELOPMENT ADVISORS
jensenbowers.com.au

72 Costin Street, Fortitude Valley, Qld. 4006
PO Box 795, Spring Hill, Qld. 4004
T: (07) 3852 1771 F: (07) 3252 9818
T.H. Jensen & Bowers Pty. Ltd. (Consulting Surveyors)
ABN: 52 010 672 607



Unitywater

NORTHEAST BUSINESS PARK C/ - KN GROUP PTY LTD CONSULTING ENGINEERS
NORTH HARBOUR - STAGE 22
AS CONSTRUCTED WATER RETICULATION

SHEET 1 OF 1 SHEETS	SCALE 1:500
REVISION DATE 30/01/19	REVISION A
DISCIPLINE CODE	
DRAWING NO. U-2018-0721	