

**LEGEND**

- ∅ Pipe Diameter
- Fire Hydrant
- Temporary Hydrant/End
- ⊗ Valve
- ① 11.25° BEND
- ② 22.5° BEND
- ③ 45° BEND
- ④ 90° BEND
- Ready Tap
- Water Meter
- C— Water Crossing
- Water Main
- DICL Water Main

**NOTES**

- Water main pipes are ∅150 PVC-0 Class PN16 unless noted otherwise.
- All road crossings are ∅150 DICL Class DN35.



**ENGINEER'S CERTIFICATION**

I, MARK SHAW being a certified / registered engineer and duly authorised representative of KN GROUP PTY LTD hereby:

- Certify the information contained in the drawing is an accurate "AS CONSTRUCTED" representation of the works.

- Accept responsibility for the "AS CONSTRUCTED" information contained in this drawing.

- Acknowledge the "AS CONSTRUCTED" information contained in drawing may be relied on by Council and others.

Certification by \_\_\_\_\_ on \_\_\_\_\_


for KN GROUP PTY LTD.  
Registered Professional Engineer of Queensland - No. 17544

**SURVEYOR'S CERTIFICATION**

We T.H. JENSEN BOWERS PTY LTD, hereby certify that the vertical and horizontal locations and dimensions shown on this plan are a true and correct record and were located by survey.

Director Date: 30/01/19

**AS CONSTRUCTED**

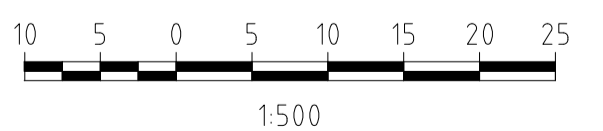

**A1**

INDEX	DATE	REVISIONS	DRAWN	CHECKED	PASSED	INITIALS	DATE
A	30/01/19	Original Issue	LB	JM			

DRAWN	LB	30/01/19	<p><b>JENSEN BOWERS</b> SURVEYORS PLANNERS DEVELOPMENT ADVISORS jensenbowers.com.au</p>
CHECKED	JM		
PASSED			

72 Costin Street, Fortitude Valley, Qld. 4006  
PO Box 790, Spring Hill, Qld. 4004  
T: (07) 3852 1271 F: (07) 3252 9818  
T.H. Jensen & Bowers Pty. Ltd. (Consulting Surveyors)  
ABN: 52 010 872 607  
© Copyright reserved to Jensen Bowers Group Consultants Pty Ltd



**Unitywater**

NORTHEAST BUSINESS PARK C/ - KN GROUP PTY LTD CONSULTING ENGINEERS  
NORTH HARBOUR - STAGE 22  
AS CONSTRUCTED WATER RETICULATION

SHEET 1 OF 1 SHEETS	SCALE 1:500
REVISION DATE 30/01/19	REVISION A
DRAWING NO. U-2018-0721	