


"I, MARK SHAW being a certified / registered engineer and duly authorised representative of KN GROUP PTY LTD hereby -

- × Certify the information contained in this drawing is an accurate "AS CONSTRUCTED" representation of the works.
- × Accept responsibility for the "AS CONSTRUCTED" information contained in this drawing.
- × Acknowledge the "AS CONSTRUCTED" information contained in the drawing may be relied on by Council and others.

Certification for Stage by on

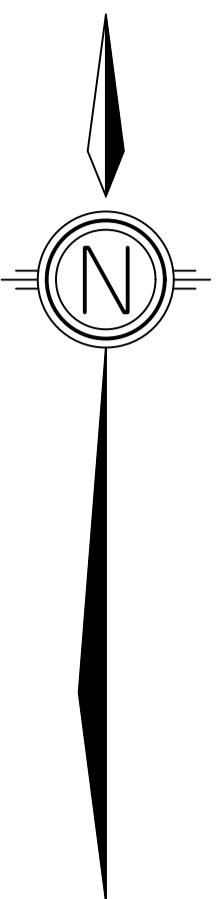
for KN GROUP PTY LTD.
Registered Professional Engineer of Queensland - No. 17544



We RPS Australia East Pty Ltd, Registered Surveyor - Land hereby certify that the Levels and Dimensions shown hereon are a correct record of our Survey which was performed in accordance with Council Accuracy Standards

 12/4/2017
Authorised Delegate Date

NOTES:

- All Sewer Lines Are 150ø uPVC Pipe Class "SN8" Unless Noted Otherwise
- All Pipe Joints Are Rubber Ring Type Unless Noted Otherwise
- All Bedding To Sewer Is "Type 3" Unless Noted Otherwise
- All Trenching Excavated In Soil
- Year Of Construction 2017
- Each Allotment Is Serviced By A 100ø uPVC House Connection



A1	-	-	-	-	-	-	-	 SCALE IN METRES		Unitywater NORTHEAST BUSINESS PARK C/ - KN GROUP PTY LTD CONSULTING ENGINEERS NORTH HARBOUR - STAGE 11 AS CONSTRUCTED SEWERAGE RETICULATION	SCALE 1500 at A1	SHEET 1 OF 1 SHEETS	
	A	2017	ORIGINAL ISSUE	RPS	RPS	-	-				DRAWING NO-	20430-187	
	INDEX	DATE	REVISIONS	DRAWN	CHECKED	PASSED	INITIALS				DATE	-	-
	DRAWN	CHECKED	PASSED	INITIALS	DATE	-	-				-	-	