


NOTES

- All Sewer Main Pipes are Ø160 PE21 PE100 Class SDR21, Unless noted otherwise.
- All Sewer House Connections are Ø110 PE, Unless noted otherwise.

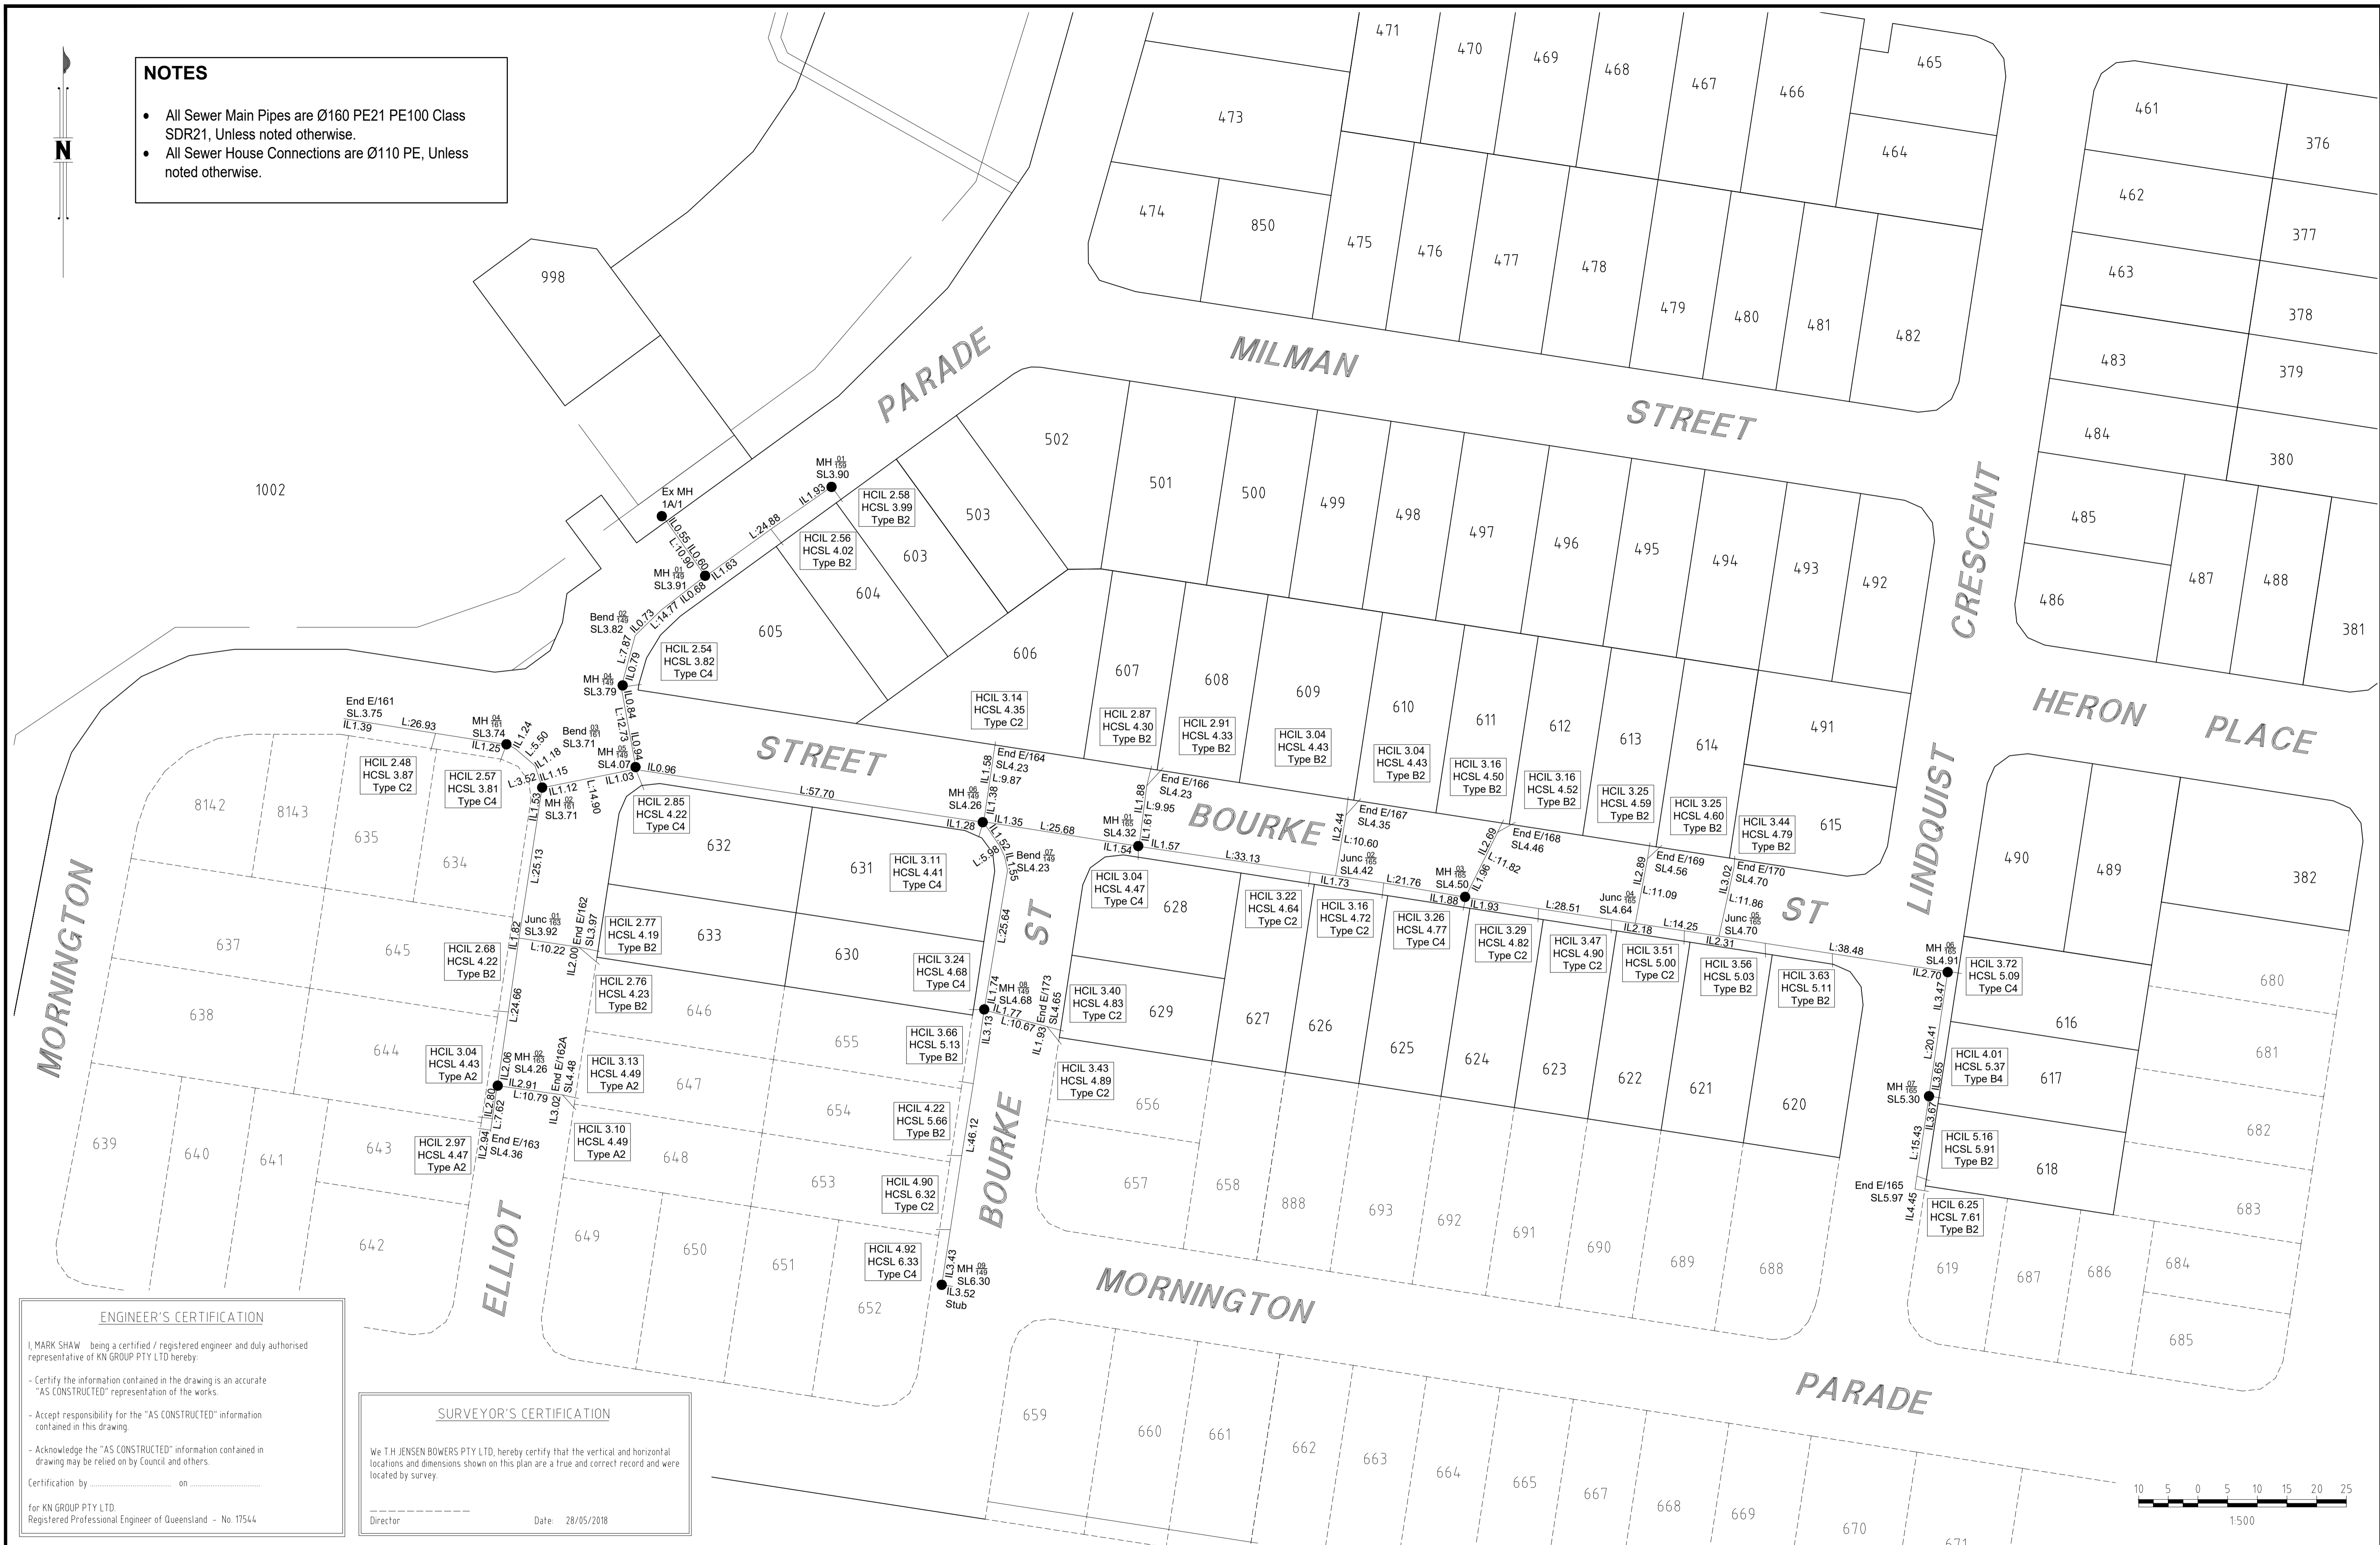

ENGINEER'S CERTIFICATION

I, MARK SHAW, being a certified / registered engineer and duly authorised representative of KN GROUP PTY LTD hereby:

- Certify the information contained in the drawing is an accurate "AS CONSTRUCTED" representation of the works.
- Accept responsibility for the "AS CONSTRUCTED" information contained in this drawing.
- Acknowledge the "AS CONSTRUCTED" information contained in drawing may be relied on by Council and others.


Certification by _____ on _____

for KN GROUP PTY LTD.
Registered Professional Engineer of Queensland - No. 17544

SURVEYOR'S CERTIFICATION

We T.H. JENSEN BOWERS PTY LTD, hereby certify that the vertical and horizontal locations and dimensions shown on this plan are a true and correct record and were located by survey.

Director _____ Date: 28/05/2018

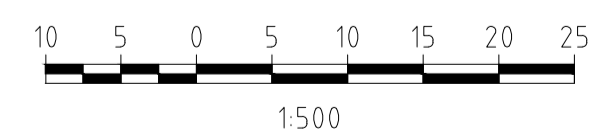

A1	A	15/05/18	Original Issue	JM	JM
	INDEX	DATE	REVISIONS	DRAWN	CHECKED

DRAWN	JM	15/05/18
CHECKED	JM	15/05/18
PASSED	JM	15/05/18
PASSED	JM	15/05/18

72 Costin Street, Fortitude Valley, Qld. 4006
PO Box 799, Spring Hill, Qld. 4004
T (07) 3862 1771 F (07) 3252 9818
T.H. Jensen & Bowers Pty Ltd (Consulting Surveyors)
ABN: 52 010 872 607
© Copyright reserved to Jensen Bowers Group Consultants Pty Ltd

Unitywater

NORTHEAST BUSINESS PARK C / - KN GROUP PTY LTD CONSULTING ENGINEERS
NORTH HARBOUR - STAGE 20
AS CONSTRUCTED SEWER RETICULATION

SHEET 1 OF 1 SHEETS	SCALE 1:500
REVISION DATE 15/05/18	REVISION A
DISCIPLINE CODE	
DRAWING NO	S-7550-024-A