

**NOTES:**

- Ø160 - Denotes Ø160 PE21 PE100 Sewer Line Pipe Class SDR21 Unless Noted Otherwise
- All Pipe Joints Are Rubber Ring Type Unless Noted Otherwise
- All Bedding To Sewer Is "Type 3" Unless Noted Otherwise
- All Trenching Excavated In Soil
- Year Of Construction 2017
- Each Allotment Is Served By A DN 110Ø PE Property Connection

"I, MARK SHAW being a certified / registered engineer and duly authorised representative of KN GROUP PTY LTD hereby -


- × Certify the information contained in this drawing is an accurate "AS CONSTRUCTED" representation of the works.
- × Accept responsibility for the "AS CONSTRUCTED" information contained in this drawing.
- × Acknowledge the "AS CONSTRUCTED" information contained in the drawing may be relied on by Council and others.

Certification for Stage ..... by ..... on .....

for KN GROUP PTY LTD.  
Registered Professional Engineer of Queensland - No. 17544

We RPS Australia East Pty Ltd, Registered Surveyor - Land hereby certify that the Levels and Dimensions shown hereon are a correct record of our Survey which was performed in accordance with Council Accuracy Standards

  
Authorised Delegate Date

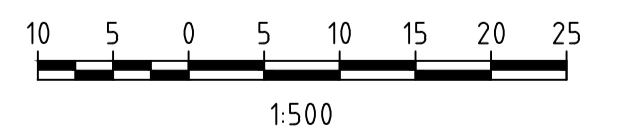

**A1**

INDEX	DATE	REVISIONS	DRAWN	CHECKED	PASSED
-	-	-	-	-	-
-	-	-	-	-	-
-	-	-	-	-	-
-	-	-	-	-	-

INITIALS	DATE
DRAWN KCH	27/11/17
CHECKED RPS	
PASSED	



RPS Australia East Pty Ltd  
ACN 140 292 762  
ABN 44 140 292 762  
743 Ann Street  
PO Box 1359  
Fortitude Valley QLD 4006  
T +61 7 3237 8899  
F +61 7 3237 8833  
W rpsgroup.com.au



**Unitywater**  
NORTHEAST BUSINESS PARK C/- KN GROUP PTY LTD CONSULTING ENGINEERS  
NORTH HARBOUR - STAGE 23  
AS CONSTRUCTED SEWER RETICULATION

SCALE	1:500
SHEET	1 OF 1 SHEETS
DRAWING NO.	20430-213