


LEGEND

- ∅ Pipe Diameter
- Fire Hydrant
- Temporary Hydrant/End
- ⊗ Valve
- ① 11.25° BEND
- ② 22.5° BEND
- ③ 45° BEND
- ④ 90° BEND
- ⊕ Ready Tap
- Water Meter
- C — Water Crossing
- Water Main
- ==== DICT Water Main

NOTES

- Water main pipes are Ø150 PVC-0 Class PN16 unless noted otherwise.
- All road crossings are Ø150 DICT Class DN35.

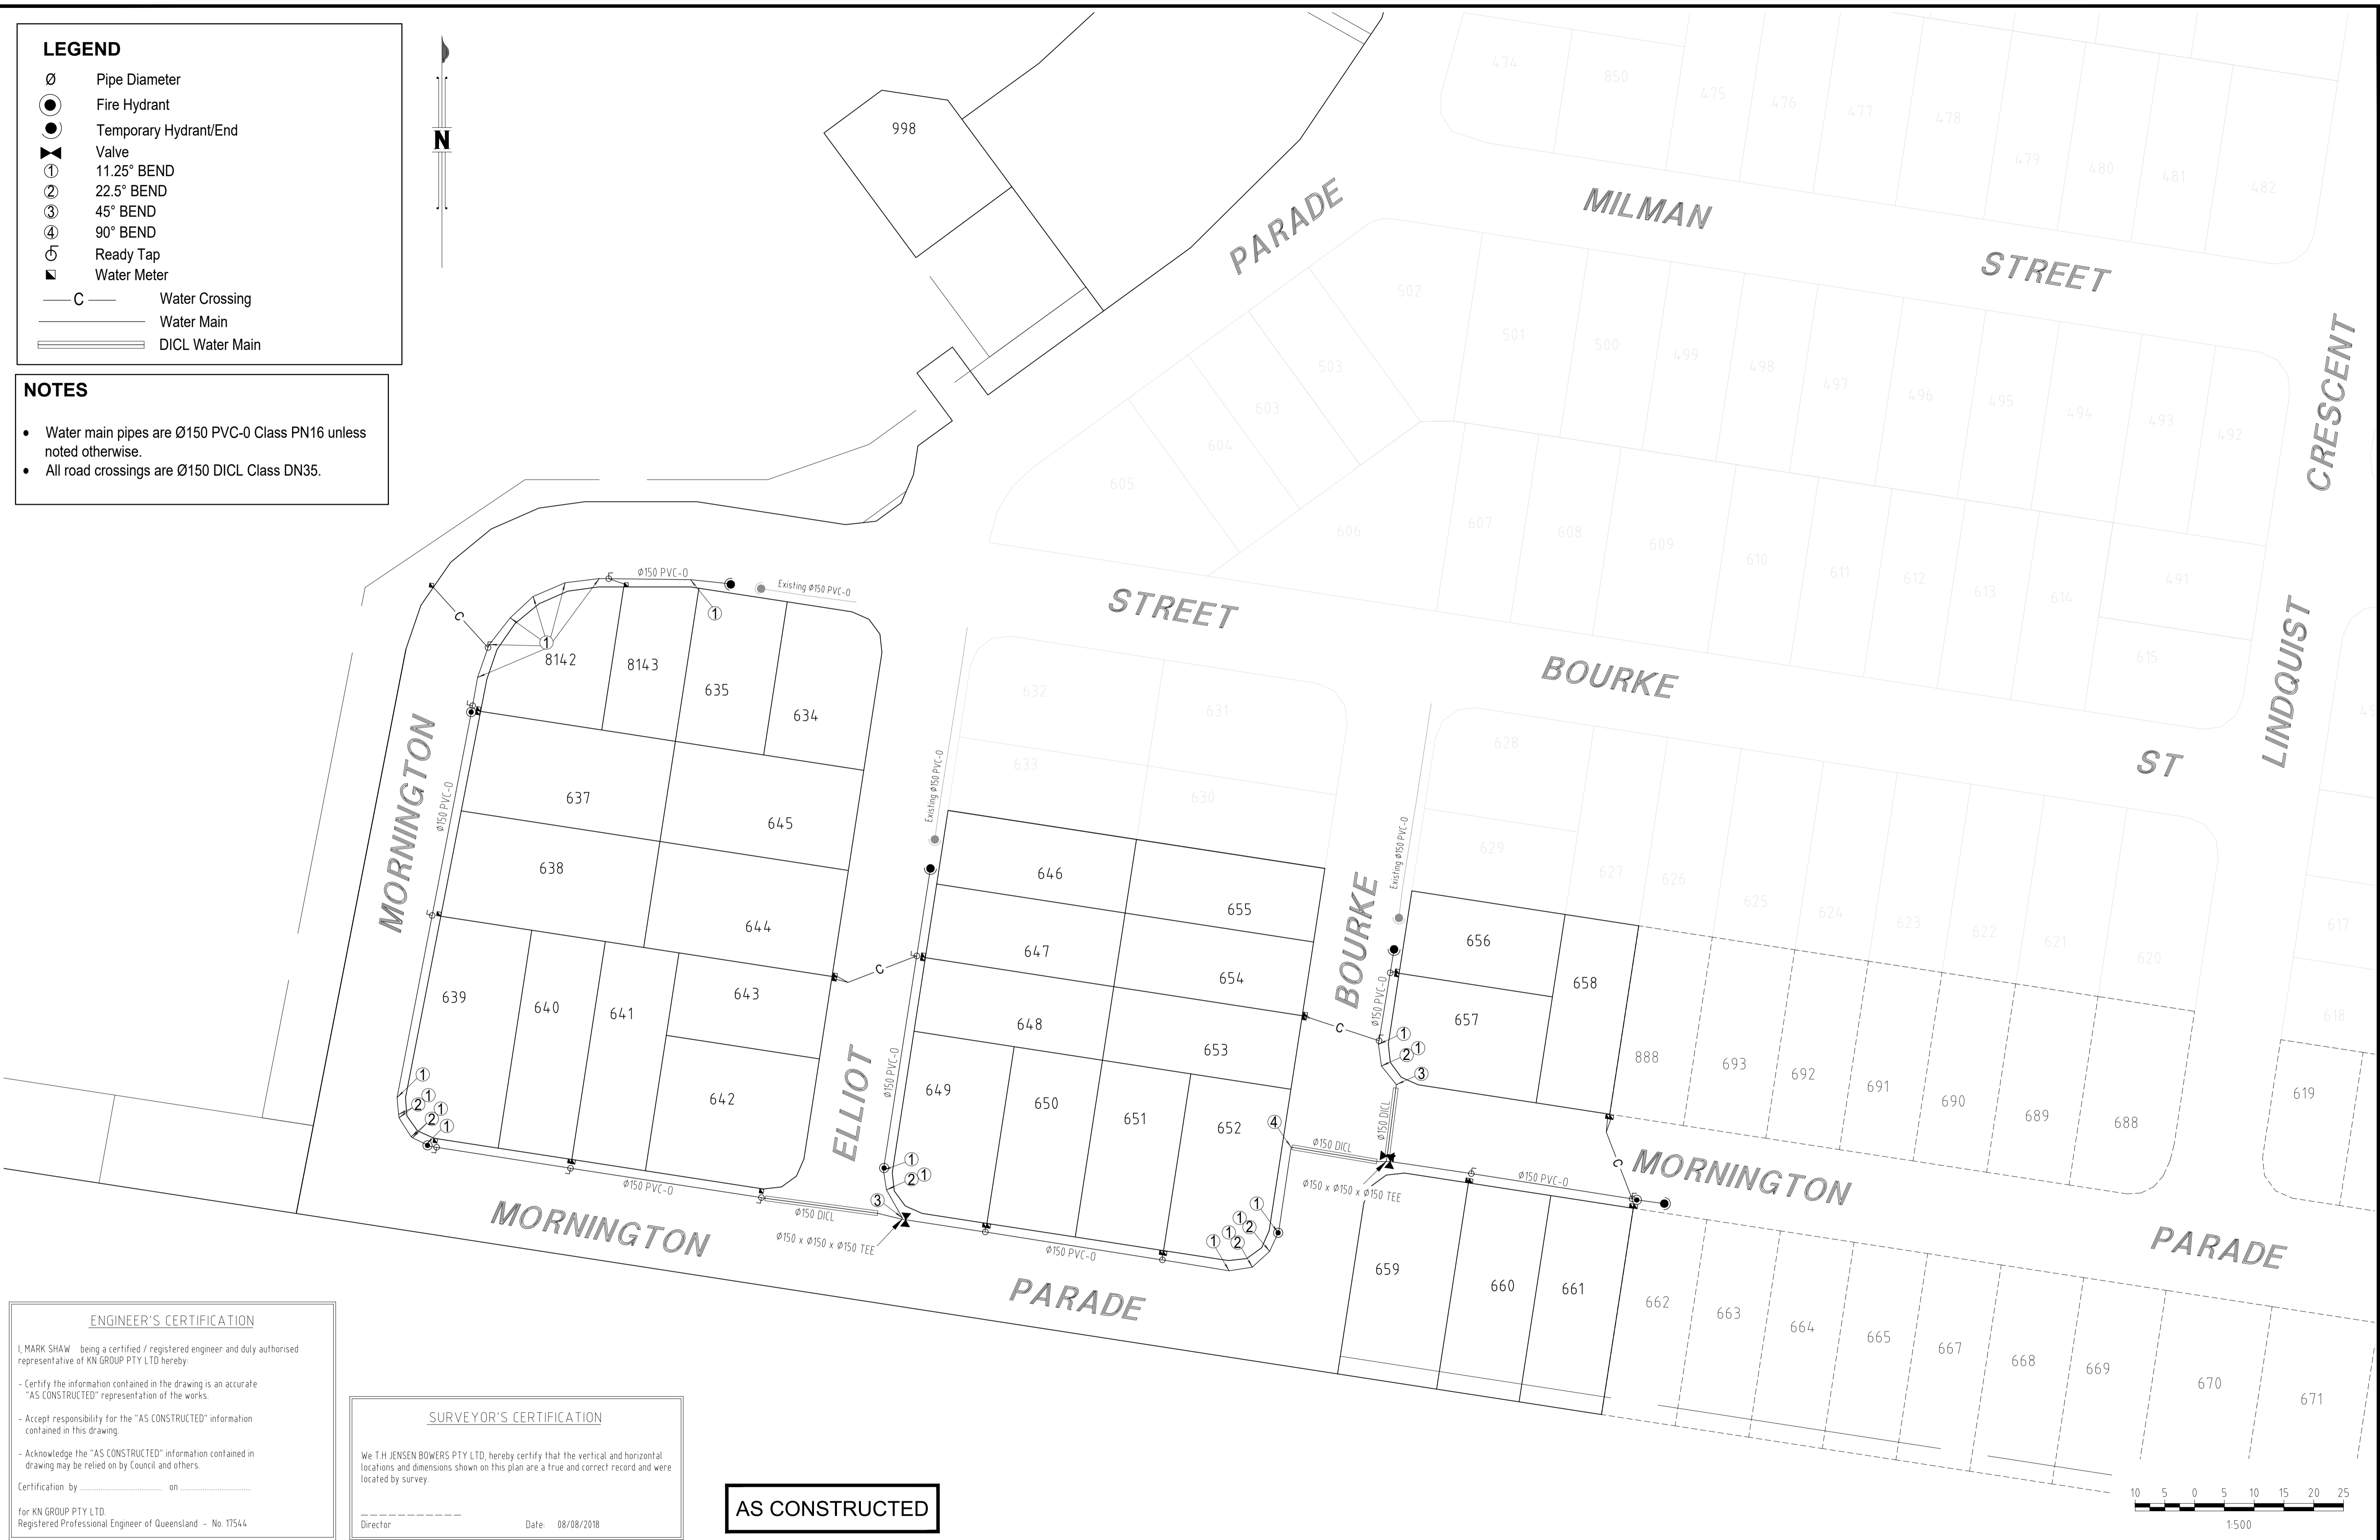

ENGINEER'S CERTIFICATION

I, MARK SHAW being a certified / registered engineer and duly authorised representative of KN GROUP PTY LTD hereby:

- Certify the information contained in the drawing is an accurate "AS CONSTRUCTED" representation of the works.
- Accept responsibility for the "AS CONSTRUCTED" information contained in this drawing.
- Acknowledge the "AS CONSTRUCTED" information contained in drawing may be relied on by Council and others.

Certification by _____ on _____


for KN GROUP PTY LTD
Registered Professional Engineer of Queensland - No. 17544

SURVEYOR'S CERTIFICATION

We T.H. JENSEN BOWERS PTY LTD, hereby certify that the vertical and horizontal locations and dimensions shown on this plan are a true and correct record and were located by survey.

Director _____ Date: 08/08/2018

AS CONSTRUCTED

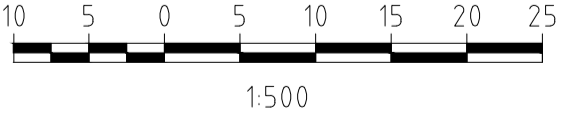

| | | | | | | | | | |
|----|-------|----------|----------------|-------|---------|--------|--|--|--|
| A1 | A | 18/07/18 | Original Issue | JM | JM | | | | |
| | INDEX | DATE | REVISIONS | DRAWN | CHECKED | PASSED | | | |

| | | | | |
|----------|----|----------|--|--|
| DRAWN | JM | 15/07/18 | | |
| CHECKED | JM | 18/07/18 | | |
| PASSED | | | | |
| INITIALS | | DATE | | |

JENSEN BOWERS

SURVEYORS PLANNERS DEVELOPMENT ADVISORS

72 Costin Street, Fortitude Valley, Qld. 4006
PO Box 799, Spring Hill, Qld. 4004
T: (07) 3862 1771 F: (07) 3252 9818
T.H. Jensen & Bowers Pty Ltd. (Consulting Surveyors)
ABN: 52 010 872 607
© Copyright reserved to Jensen Bowers Group Consultants Pty Ltd



Unitywater

NORTHEAST BUSINESS PARK C/ - KN GROUP PTY LTD CONSULTING ENGINEERS
NORTH HARBOUR - STAGE 21
AS CONSTRUCTED WATER RETICULATION

| | |
|-------------------------|-------------|
| SHEET 1 OF 1 SHEETS | SCALE 1:500 |
| REVISION DATE 18/07/18 | REVISION A |
| DISCIPLINE CODE | |
| DRAWING NO. U-2018-0745 | |