



1002

**SURVEYOR'S CERTIFICATION**

We T.H. JENSEN BOWERS PTY LTD, hereby certify that the vertical and horizontal locations and dimensions shown on this plan are a true and correct record and were located by survey.

Director \_\_\_\_\_ Date: 08/08/2018

**ENGINEER'S CERTIFICATION**

I, MARK SHAW, being a certified / registered engineer and duly authorised representative of KN GROUP PTY LTD hereby:

- Certify the information contained in the drawing is an accurate "AS CONSTRUCTED" representation of the works.
- Accept responsibility for the "AS CONSTRUCTED" information contained in this drawing.
- Acknowledge the "AS CONSTRUCTED" information contained in drawing may be relied on by Council and others.

Certification by \_\_\_\_\_ on \_\_\_\_\_

for KN GROUP PTY LTD  
Registered Professional Engineer of Queensland - No. 17544

**Legend**

	Road Kerb Invert
	Bottom of Bank
	Top of Bank
	Change of Grade
	Retaining Wall
	Contour Major
	Contour Minor
	Fence Line
	Concrete Path
	Landscaped Area
	Surface Level




72 Costin Street, Fortitude Valley, Qld. 4006  
PO Box 799, Spring Hill, Qld. 4004  
T (07) 3852 1771 F (07) 3252 9818  
T.H. Jensen & Bowers Pty. Ltd. (Consulting Surveyors)  
ABN: 52 010 872 607  
© Copyright reserved to Jensen Bowers Group Consultants Pty Ltd

**Associated Consultants**

Local Authority: Morton Bay Regional Council  
Authority Ref. No:  
RP Description: Lot 2000 on SP289851

Original Portion:  
Date of Survey: 13/07/18  
Level Datum:  
Origin:  
Level Bk / Fid Bk:  
Horizontal Datum: SP289851  
Contour Interval: N/A

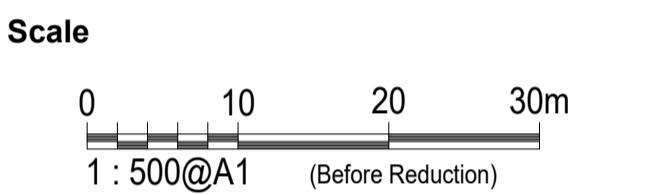

The services shown hereon have been located where possible by field survey. Whilst due care and attention have been exercised, T.H. Jensen and Bowers Pty. Ltd. does not warrant that the services have been located in their entirety.

The boundaries shown hereon are for plotting purposes only and are subject to final survey.

The location of underground service lines are approximate only and have been plotted from field survey observations and/or service searches. Should their accurate location be critical to detail design we recommend further investigation.

**Disclaimer**  
Any licence, expressed or implied, to use this document for any purpose whatsoever is restricted to the terms of the agreement or implied agreement between Jensen Bowers and the instructing party.

Drawn: JM	Date: 15/05/18
Surveyed: LB	Date: 13/07/18
Checked: JM	Date: 08/08/18
Approved:	

Issue	Description	Date	Appd.
A	Original Issue	08/08/18	JM

**Client**  
Northeast Business Park Pty Ltd

**North Harbour  
Buckley Road  
Burpengary East**

**As Constructed  
Finished Surface  
Stage 21**

Drawing No.	Issue	Original Size
S-7550-129	A	A1

