

PSM 724.18
 E: 498714.197
 N: 6999186.146
 RL: 14.859m



UNITYWATER PROJECT NUMBER 2016009402S30

Stage 30, North Harbour Estate

WATER MAIN



DRAWING INDEX	
DRAWING NUMBER	DESCRIPTION
U-2022-4057	LOCALITY PLAN AND DRAWING INDEX

COORDINATE DATUM NOTE:
 HORIZONTAL COORDINATES(E,N) SUPPLIED ARE MAPPING GRID OF AUSTRALIA(MGA), ZONE 56 BASED ON THE UNIVERSAL TRANSVERSE MERCATOR PROJECTION AND THE GEOCENTRIC DATUM OF AUSTRALIA 1994.

ENGINEER'S CERTIFICATION


I, Mark Shaw, of KN GROUP PTY LTD, hereby certify that:
 1. The information contained in this drawing / document is in compliance with approved drawings and design.
 2. The new water and sewerage works defined by this drawing have been designed and constructed in accordance with the SEQ Code.
 3. This represents an accurate record of as-constructed works
 4. I accept responsibility for the information contained in this drawing / document.

Mark Shaw
 Mark Andrew Shaw (ing 0245, MGA, QLD)
 2022.11.04 11:28:15 +10:00
 RPEQ (signature) RPEQ No. 17544 Date:

REGISTERED SURVEYOR'S CERTIFICATION

We, T.H. JENSEN BOWERS PTY LTD, hereby certify that the vertical and horizontal locations and dimensions shown on this plan are a true and correct record and were located by survey.

T.H. Jensen
 Registered Surveyor (sig) Reg. Surveyor No. 3756 Date: 03/11/22

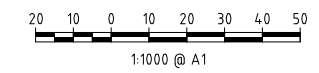

AS CONSTRUCTED


A1	INDEX	DATE	REVISIONS	DRAWN	CHECKED	PASSED	INITIALS	DATE	 JENSEN BOWERS <small>72 Costin Street, Fortitude Valley, Qld. 4006 PO Box 790, Spring Hill, Qld. 4004 T (07) 3852 1771 F (07) 3852 9818 T.H. Jensen & Bowers Pty. Ltd. (Consulting Surveyors) ABN: 52 010 872 657 © Copyright reserved to Jensen Bowers Group Consultants Pty Ltd</small>	 Unitywater <small>2016009402S30 North Harbour Stage 30</small>	SHEET 1 OF 2 SHEETS	SCALE 1:1000
											REVISION DATE 03-11-2022 REVISION A	DISCIPLINE CODE C

LEGEND

- ∅ Pipe Diameter
- Fire Hydrant
- Temporary Hydrant/End Valve
- ① 11.25° BEND
- ② 22.5° BEND
- ③ 45° BEND
- ④ 90° BEND
- ⊕ Ready Tap
- Water Meter
- Water Crossing
- Water Main
- DICL Water Main

NOTES

- Water main pipes are Ø150 PVC-0 Class PN16 unless noted otherwise.
- All road crossings are Ø150 DICL Class DN35 unless noted otherwise.

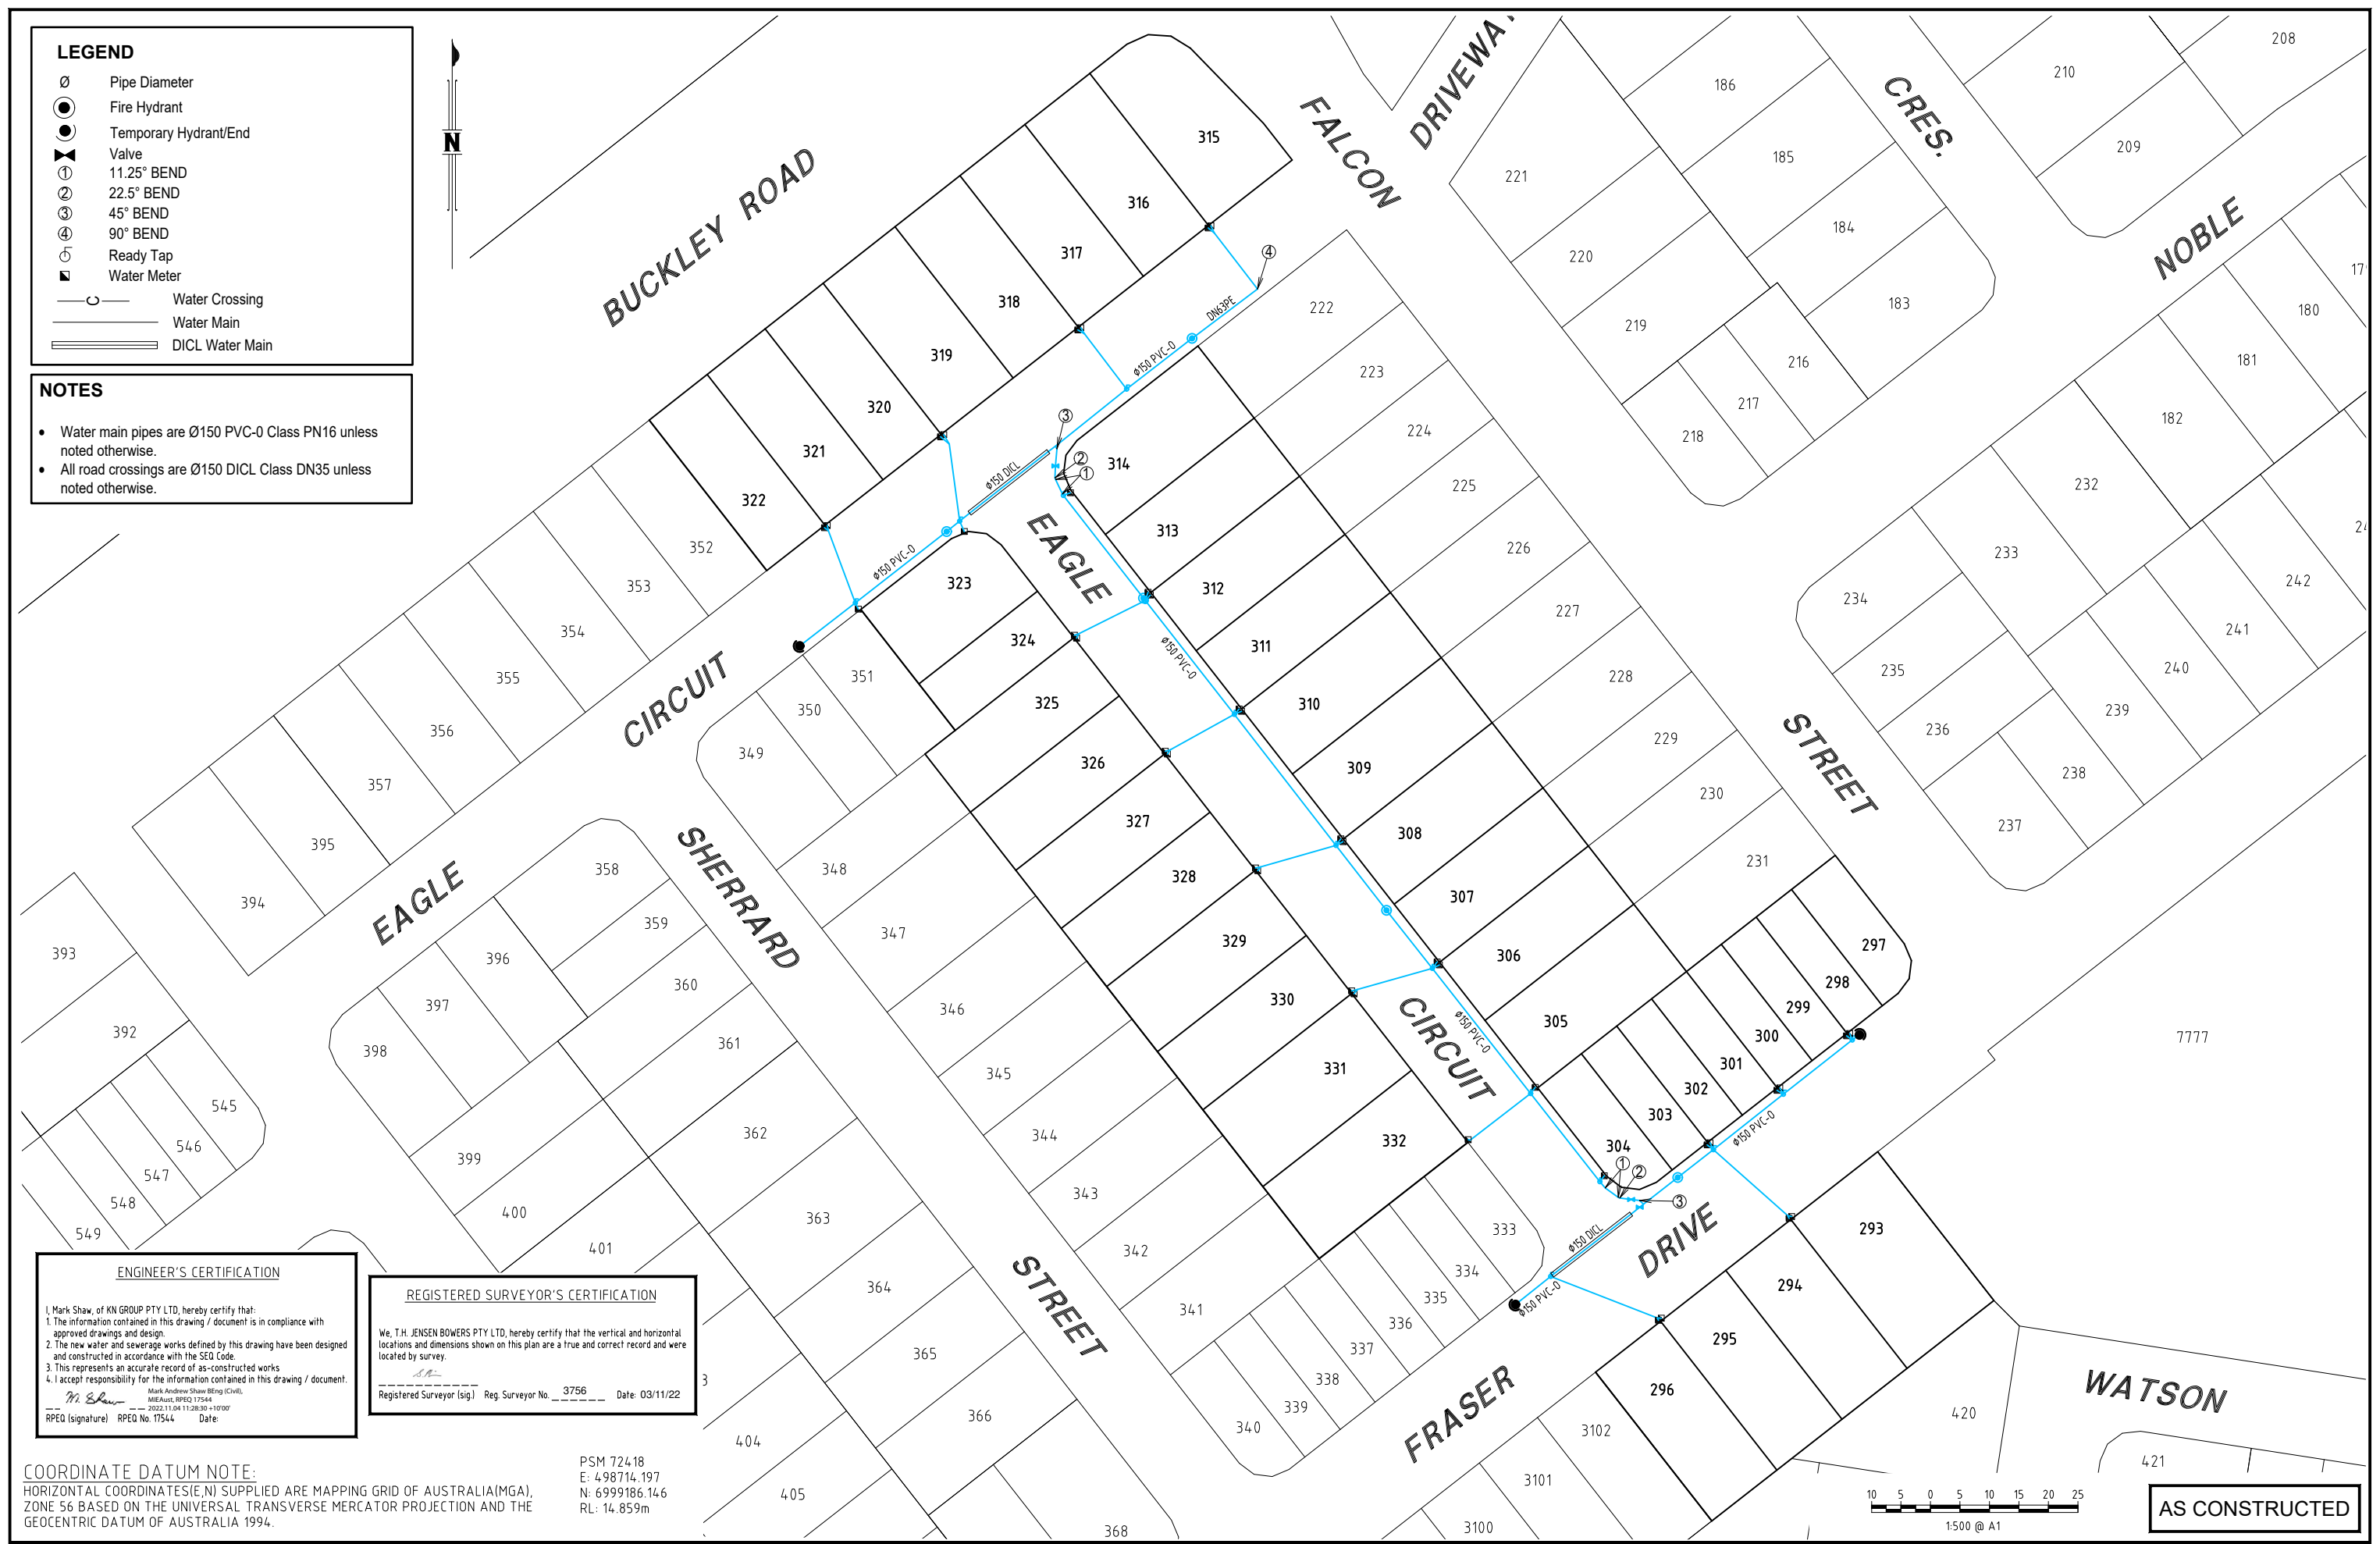

ENGINEER'S CERTIFICATION

I, Mark Shaw, of KN GROUP PTY LTD, hereby certify that:
 1. The information contained in this drawing / document is in compliance with approved drawings and design.
 2. The new water and sewerage works defined by this drawing have been designed and constructed in accordance with the SEQ Code.
 3. This represents an accurate record of as-constructed works.
 4. I accept responsibility for the information contained in this drawing / document.

Mark Shaw (Signature)
 Mark Andrew Shaw BEng (Civil),
 MIEAust, RPEQ 17544
 2022.11.04 11:28:30 +10'00'
 RPEQ (signature) RPEQ No. 17544 Date:


REGISTERED SURVEYOR'S CERTIFICATION

We, T.H. JENSEN BOWERS PTY LTD, hereby certify that the vertical and horizontal locations and dimensions shown on this plan are a true and correct record and were located by survey.

[Signature]
 Registered Surveyor (sig) Reg. Surveyor No. 3756 Date: 03/11/22

COORDINATE DATUM NOTE:
 HORIZONTAL COORDINATES (E,N) SUPPLIED ARE MAPPING GRID OF AUSTRALIA (MGA), ZONE 56 BASED ON THE UNIVERSAL TRANSVERSE MERCATOR PROJECTION AND THE GEOCENTRIC DATUM OF AUSTRALIA 1994.

PSM 724.18
 E: 4.98714.197
 N: 6.999186.14.6
 RL: 14.859m

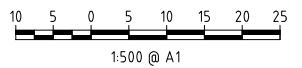

AS CONSTRUCTED

A1						
	A	03/11/2022	Original Issue	JB	SJM	DB
	REVISIONS			DRAWN	CHECKED	PASSED
	INDEX	DATE		INITIALS	DATE	

DRAWN	JB	03/11/2022	<p>JENSEN BOWERS SURVEYORS PLANNERS DEVELOPMENT ADVISORS jensenbowers.com.au</p>
CHECKED	SJM	03/11/2022	
PASSED	DB	03/11/2022	

72 Costin Street, Fortitude Valley, Qld. 4006
 PO Box 720, Spring Hill, Qld. 4004
 T (07) 3852 1771 F (07) 3252 9818
 T.H. Jensen & Bowers Pty. Ltd. (Consulting Surveyors)
 ABN: 52 010 872 607
 ©Copyright reserved to Jensen Bowers Group Consultants Pty Ltd.



Unitywater
 2016009402S30
 North Harbour Stage 30

SHEET 2 OF 2 SHEETS	SCALE 1:500
REVISION DATE 03-11-2022	REVISION A
DISCIPLINE CODE C	
DRAWING NO. U-2022-4057	