

Legend	
	Road Kerb Invert
	Bottom of Bank
	Top of Bank
	Change of Grade
	Retaining Wall
	Contour Major
	Contour Minor
	Fence Line
	Concrete Path
	Surface Level

ENGINEER'S CERTIFICATION

I, MARK SHAW being a certified / registered engineer and duly authorised representative of KN GROUP PTY LTD hereby:

- Certify the information contained in the drawing is an accurate "AS CONSTRUCTED" representation of the works.
- Accept responsibility for the "AS CONSTRUCTED" information contained in this drawing.
- Acknowledge the "AS CONSTRUCTED" information contained in drawing may be relied on by Council and others.


Certification by: *M. Shaw* Mark Andrew Shaw (Eng)
CIVIL, MGP Reg. No. 11544
 2023.02.03 13:25:22 +10:00

for KN GROUP PTY LTD.
 Registered Professional Engineer of Queensland - No. 17544

SURVEYOR'S CERTIFICATION

We T.H. JENSEN BOWERS PTY LTD, hereby certify that the vertical and horizontal locations and dimensions shown on this plan are a true and correct record and were located by survey.

T.H. Jensen
 Director Date: 03/02/2023

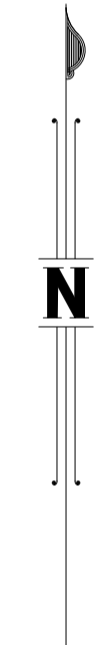

JENSEN BOWERS SURVEYORS PLANNERS DEVELOPMENT ADVISORS
 jensenbowers.com.au

72 Costin Street, Fortitude Valley, Qld. 4006
 PO Box 799, Spring Hill, Qld. 4004
 T (07) 3852 1771 F (07) 3252 9818


T.H. Jensen & Bowers Pty. Ltd. (Consulting Surveyors)
 ABN. 52 010 872 607

© Copyright reserved to Jensen Bowers Group Consultants Pty Ltd

Associated Consultants

Local Authority: Moreton Bay Regional Council
 Authority Ref. No:
 RP Description: Lots 333-3732 & 3100-3102 on SP20581

Original Portion: 10 & 24
 Date of Survey: 10/05/2022
 Level Datum: AHD (der)
 Origin: OPM 103504 (RL19.282)
 Level Bk / Fld Bk: Digital
 Horizontal Datum: MGA
 Contour Interval: 0.5m

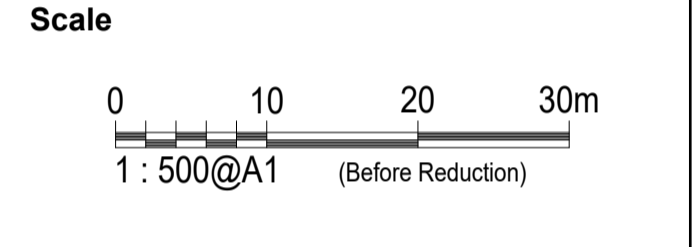

The services shown hereon have been located where possible by field survey. Whilst due care and attention have been exercised, T.H. Jensen and Bowers Pty. Ltd. does not warrant that the services have been located in their entirety.

Disclaimer
 Any licence, expressed or implied, to use this document for any purpose whatsoever is restricted to the terms of the agreement or implied agreement between Jensen Bowers and the instructing party.

Drawn: JB	Date: 13/05/2022
Surveyed: JB	Date: 10/05/2022
Checked: SJM	Date: 13/05/2022
Approved: SJM	

Issue	Description	Date	Appd.
A	Original Issue	13/05/22	DB

Client
 NORTH HARBOUR HOLDINGS P/L

**North Harbour
 Buckley Road
 Burpengary East**

**As Constructed
 Finished Stage 31**

Drawing No.	Issue	Original Size
S-7550-327	A	A1