


**LEGEND**

- Ø Pipe Diameter
- L Length
- IL Invert Level
- SL Surface Level
- MH Manhole
- USIL Up Stream Invert Level
- DSIL Down Stream Invert Level
- Gully Pit

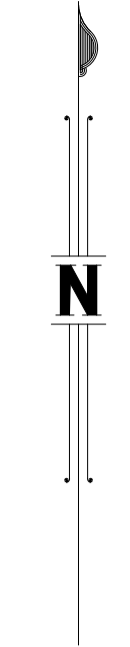

**ENGINEER'S CERTIFICATION**

I, MARK SHAW being a certified / registered engineer and duly authorised representative of KN GROUP PTY LTD hereby:

- Certify the information contained in the drawing is an accurate "AS CONSTRUCTED" representation of the works.
- Accept responsibility for the "AS CONSTRUCTED" information contained in this drawing.
- Acknowledge the "AS CONSTRUCTED" information contained in drawing may be relied on by Council and others.

Certification by *M. Shaw* Mark Andrew Shaw BEng  
0945 000000, 0905 12544, 2023.02.03 15:24:18 +10:00

for KN GROUP PTY LTD.  
 Registered Professional Engineer of Queensland - No. 17544

**SURVEYOR'S CERTIFICATION**

We T.H. JENSEN BOWERS PTY LTD, hereby certify that the vertical and horizontal locations and dimensions shown on this plan are a true and correct record and were located by survey.

*T.H. Jensen Bowers*  
 Director

03/02/2023



**JENSEN BOWERS**  
 SURVEYORS PLANNERS DEVELOPMENT ADVISORS  
 jensenbowers.com.au

72 Costin Street, Fortitude Valley, Qld. 4006  
 PO Box 799, Spring Hill, Qld. 4004  
 T (07) 3852 1771 F (07) 3252 9818

T.H. Jensen & Bowers Pty. Ltd. (Consulting Surveyors)  
 ABN. 52 010 872 607

© Copyright reserved to Jensen Bowers Group Consultants Pty Ltd

**Associated Consultants**

Local Authority: Moreton Bay Regional Council  
 Authority Ref. No:  
 RP Description: Lots 333-373 & 3100-3102 on SP320581

Original Portion: 10 & 24  
 Date of Survey: 10/05/2022  
 Level Datum: AHD (der)  
 Origin: OPM 103504 (RL19.282)  
 Level Bk / Fld Bk: Digital  
 Horizontal Datum: MGA  
 Contour Interval: N/A

**Scale**

1 : 500@A1 (Before Reduction)

The services shown hereon have been located where possible by field survey. Whilst due care and attention have been exercised, T.H. Jensen and Bowers Pty. Ltd. does not warrant that the services have been located in their entirety.

**Disclaimer**

Any licence, expressed or implied, to use this document for any purpose whatsoever is restricted to the terms of the agreement or implied agreement between Jensen Bowers and the instructing party.

Drawn: JB	Date: 11/05/2022
Surveyed: JB	Date: 10/05/2022
Checked: SJM	Date: 11/05/2022

Approved: SJM

Issue	Description	Date	Appd.
A	Original Issue	11/05/22	SJM

**Client**  
 NORTH HARBOUR HOLDINGS P/L

**North Harbour  
 Buckley Road  
 Burpengary East**

**As Constructed  
 Stormwater  
 Stage 31**

Drawing No.	Issue	Original Size
S-7550-326	A	A1