

LEGEND

- Ø Pipe Diameter
- L Length
- IL Invert Level
- SL Surface Level
- MH Manhole
- USIL Up Stream Invert Level
- DSIL Down Stream Invert Level
- Gully Pit



ENGINEER'S CERTIFICATION

I, MARK SHAW being a certified / registered engineer and duly authorised representative of KN GROUP PTY LTD hereby:

- Certify the information contained in the drawing is an accurate "AS CONSTRUCTED" representation of the works.
- Accept responsibility for the "AS CONSTRUCTED" information contained in this drawing.
- Acknowledge the "AS CONSTRUCTED" information contained in drawing may be relied on by Council and others.

Certification by *M. Shaw* (Signature)
 Mark Andrew Shaw BEng
 ICivil, MEMA, MPEQ
 17544
 2023 1201 135002
 +10007
 for KN GROUP PTY LTD.
 Registered Professional Engineer of Queensland - No. 17544

SURVEYOR'S CERTIFICATION

We T.H. JENSEN BOWERS PTY LTD, hereby certify that the vertical and horizontal locations and dimensions shown on this plan are a true and correct record and were located by survey.

S.M. (Signature)
 Director

01/12/23



72 Costin Street, Fortitude Valley, Qld. 4006
 PO Box 799, Spring Hill, Qld. 4004
 T (07) 3852 1771 F (07) 3252 9818


T.H. Jensen & Bowers Pty. Ltd. (Consulting Surveyors)
 ABN: 52 010 872 607

© Copyright reserved to Jensen Bowers Group Consultants Pty Ltd

Associated Consultants

Local Authority: Moreton Bay Regional Council
 Authority Ref. No:
 RP Description: Lots 485-494, 497-525 on SP320584

Original Portion: 10 & 24
 Date of Survey: 13/10/2023
 Level Datum: AHD (der)
 Origin: OPM 103504 (RL19.282)
 Level Bk / Fld Bk: Digital
 Horizontal Datum: MGA
 Contour Interval: N/A

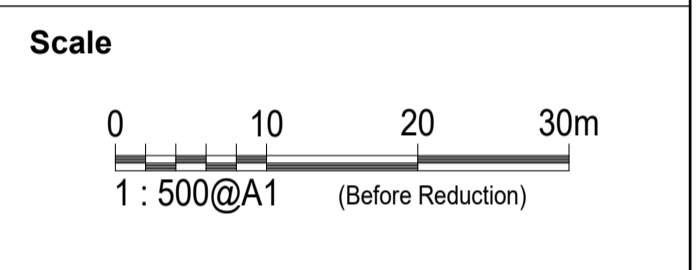

The services shown hereon have been located where possible by field survey. Whilst due care and attention have been exercised, T.H. Jensen and Bowers Pty. Ltd. does not warrant that the services have been located in their entirety.

Disclaimer

Any licence, expressed or implied, to use this document for any purpose whatsoever is restricted to the terms of the agreement or implied agreement between Jensen Bowers and the instructing party.

Drawn: JB	Date: 13/10/2023
Surveyed: JB	Date: 13/10/2023
Checked: SJM	Date: 13/10/2023
Approved: SJM	

Issue	Description	Date	Appd.
A	Original Issue	03/11/23	SJM

Client
 NORTH HARBOUR HOLDINGS P/L

**North Harbour
 Buckley Road
 Burpengary East**

**As Constructed
 Stormwater
 Stage 39**

Drawing No.	Issue	Original Size
S-7550-S3901	A	A1