




**NOTES**

- All Sewer Main Pipes are DN160 PE100 SDR21 PN8, White Wall.
- All Sewer House Connections are DN110 PE100 SDR21 PN8, White Wall.

**LEGEND**

- x Pipe Size Change from DN160 to DN110
- Y DN160/110 45 Degree Junction
- Easement Line

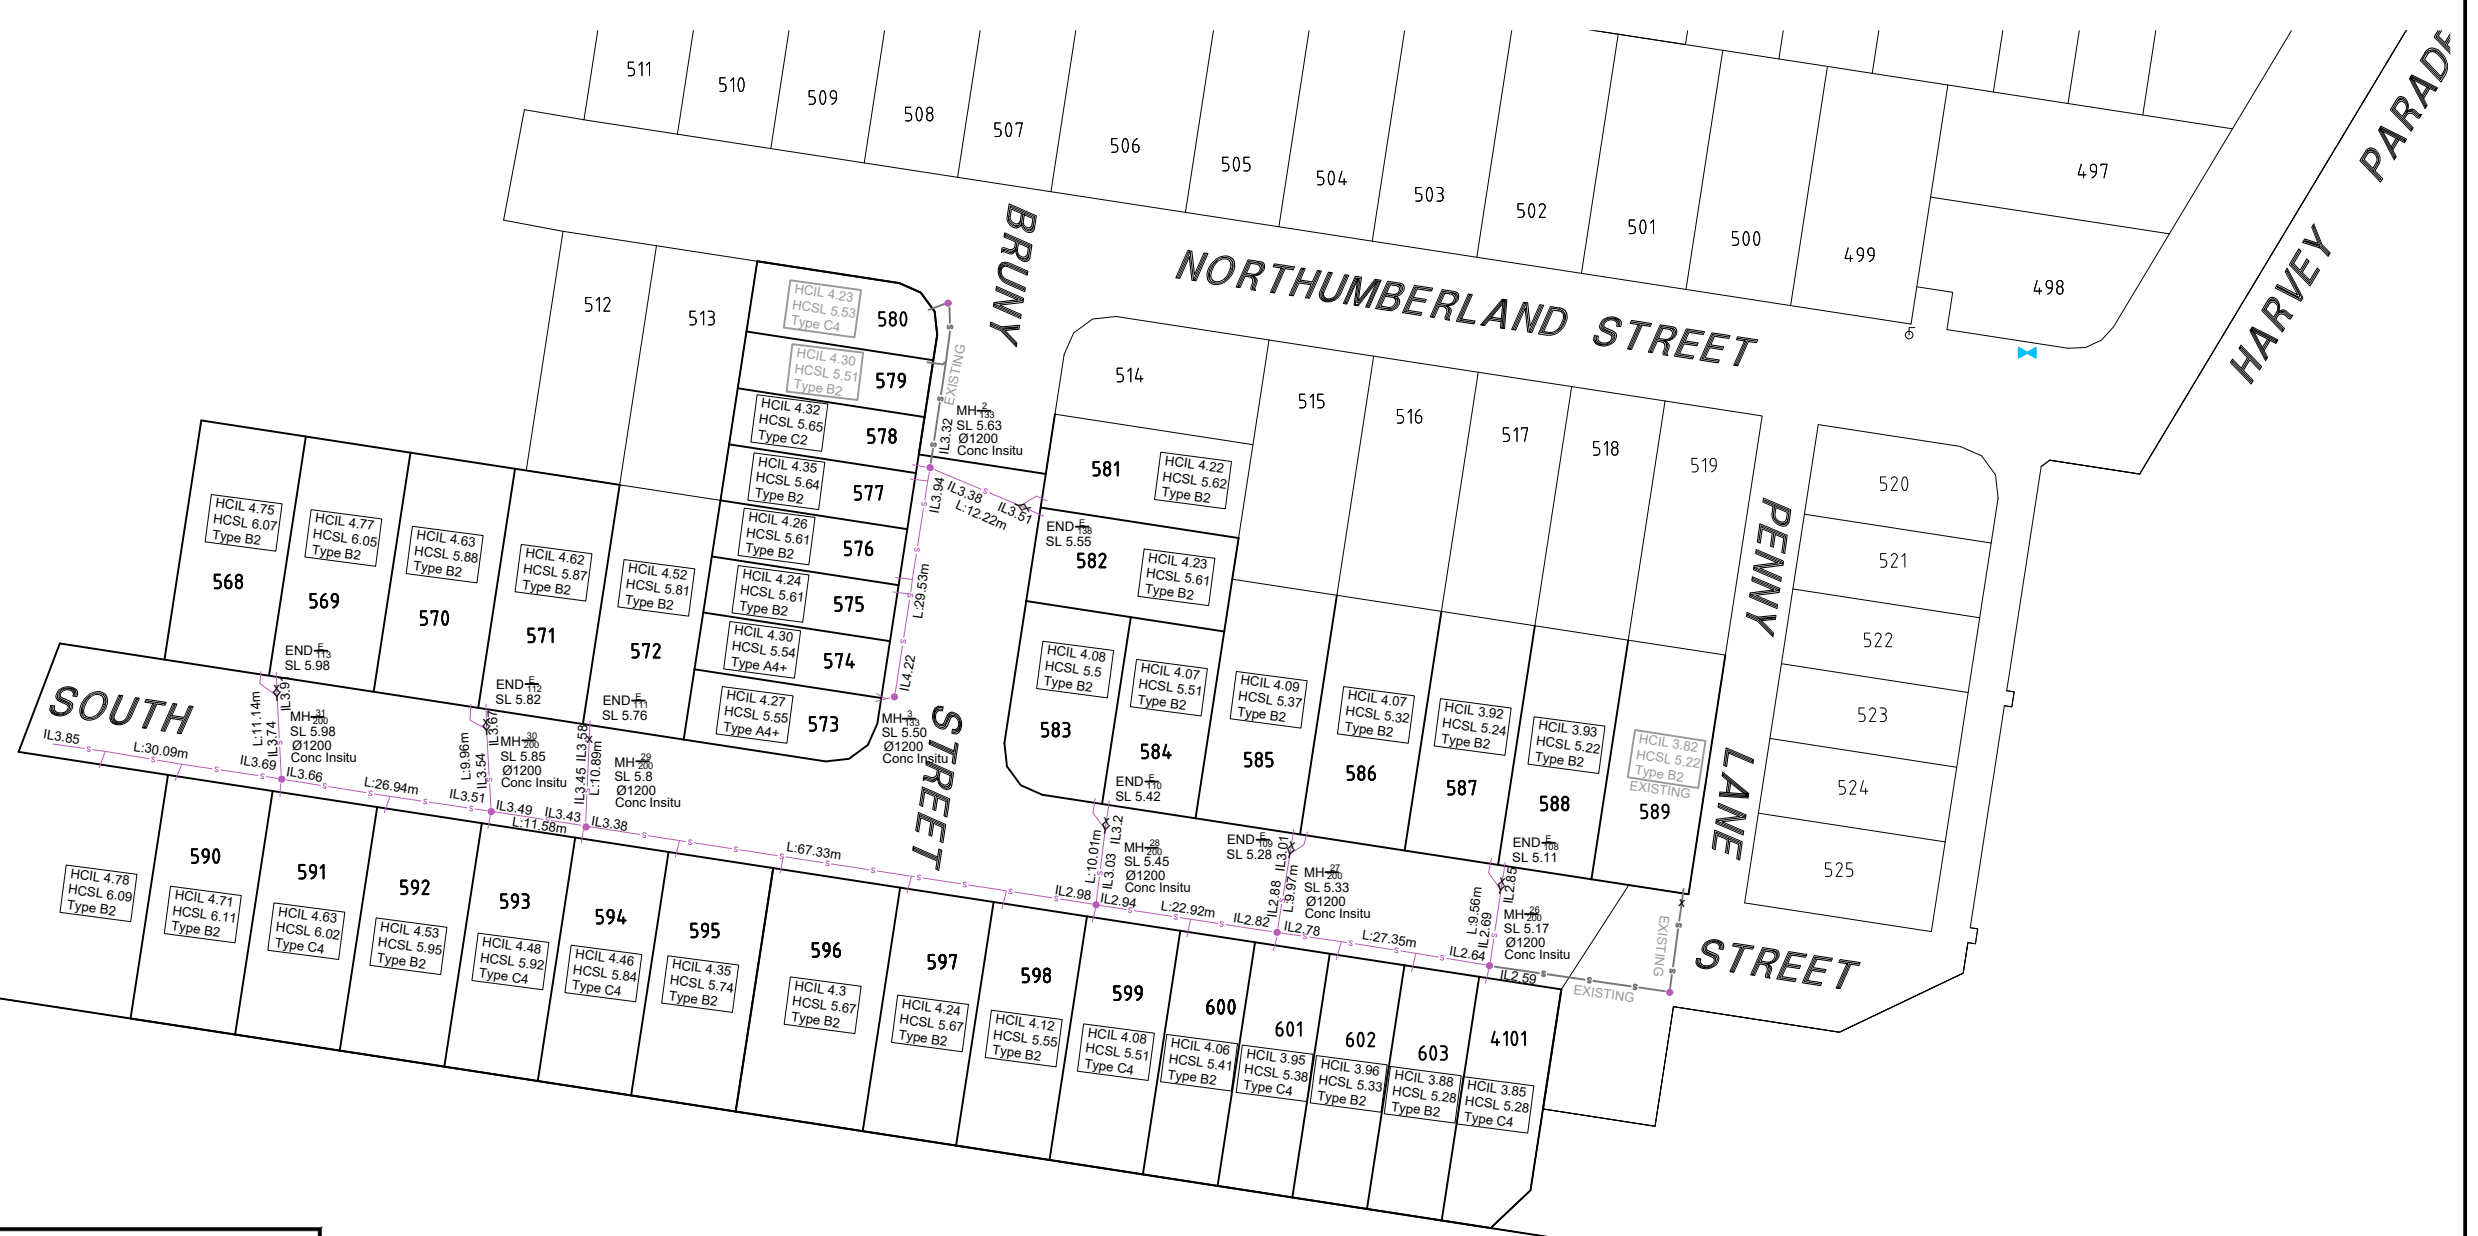

**ENGINEER'S CERTIFICATION**

I, Mark Shaw, of KN GROUP PTY LTD, hereby certify that:  
 1. The information contained in this drawing / document is in compliance with approved drawings and design.  
 2. The new water and sewerage works defined by this drawing have been designed and constructed in accordance with the SEQ Code.  
 3. This represents an accurate record of as-constructed works  
 4. I accept responsibility for the information contained in this drawing / document.

RPED (signature) RPED No. 17544 Date:

**REGISTERED SURVEYOR'S CERTIFICATION**


We, T.H. JENSEN BOWERS PTY LTD, hereby certify that the vertical and horizontal locations and dimensions shown on this plan are a true and correct record and were located by survey.

Registered Surveyor (sig) Reg. Surveyor No. 3756 Date: 20/03/24

**COORDINATE DATUM NOTE:**

HORIZONTAL COORDINATES (E,N) SUPPLIED ARE MAPPING GRID OF AUSTRALIA (MGA), ZONE 56 BASED ON THE UNIVERSAL TRANSVERSE MERCATOR PROJECTION AND THE GEOCENTRIC DATUM OF AUSTRALIA 1994.

PSM 724.18  
 E: 498714.197  
 N: 6999186.146  
 RL: 14.859m

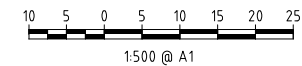

**AS CONSTRUCTED**

**A1**

INDEX	DATE	REVISIONS	DRAWN	CHECKED	PASSED
A	05/02/2024	Original Issue	WK	SJM	DB

DRAWN	WK	05/02/2024
CHECKED	SJM	05/02/2024
PASSED	DB	05/02/2024

72 Coatin Street, Fortitude Valley, Qld. 4006  
 PO Box 790, Spring Hill, Qld. 4004  
 T: (07) 3652 1771 F: (07) 3252 8418  
 T.H. Jensen & Bowers Pty. Ltd. (Consulting Surveyors)  
 ABN 52 019 872 607  
 SURVEYORS PLANNERS DEVELOPMENT ADVISORS  
 jensenbowers.com.au

**Unitywater**

2016008075541  
 North Harbour Stage 41

SHEET 2 OF 3 SHEETS SCALE 1:1000

REVISION DATE 05-02-2024 REVISION A

DISCIPLINE CODE C

DRAWING NO. U-2023-5194