

We, T.H. JENSEN BOWERS PTY LTD, hereby certify that the vertical and horizontal locations and dimensions shown on this plan are a true and correct record and were located by survey.

Registered Surveyor (sig.) Reg. Surveyor No. 3756 Date: 14/08/25



I, MARK SHAW being a certified / registered engineer and duly authorised representative of KN GROUP PTY LTD hereby:

- Certify the information contained in the drawing is an accurate "AS CONSTRUCTED" representation of the works.
- Accept responsibility for the "AS CONSTRUCTED" information contained in this drawing.
- Acknowledge the "AS CONSTRUCTED" information contained in drawing may be relied on by Council and others.

Certification by *M. Shaw*
 DEPT CIVIL, MECHANICAL, ELECTRICAL, PLUMBING
 19020 17544
 2025.08.14 15:52:44
 +10'00'

for KN GROUP PTY LTD.
 Registered Professional Engineer of Queensland - No. 17544

---	Road Kerb Invert
- - - - -	Bottom of Bank
+++++	Top of Bank
- - - - -	Change of Grade
=====	Retaining Wall
=====	Contour Major
=====	Contour Minor
——//——	Fence Line
	Concrete Path
=====	Surface Level

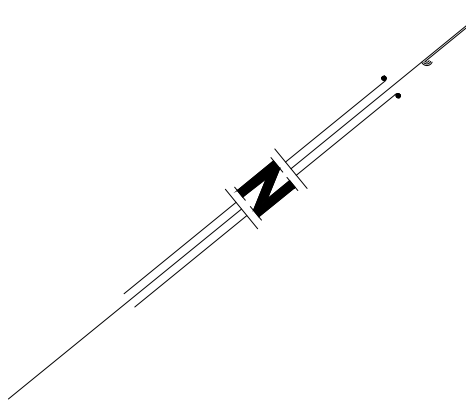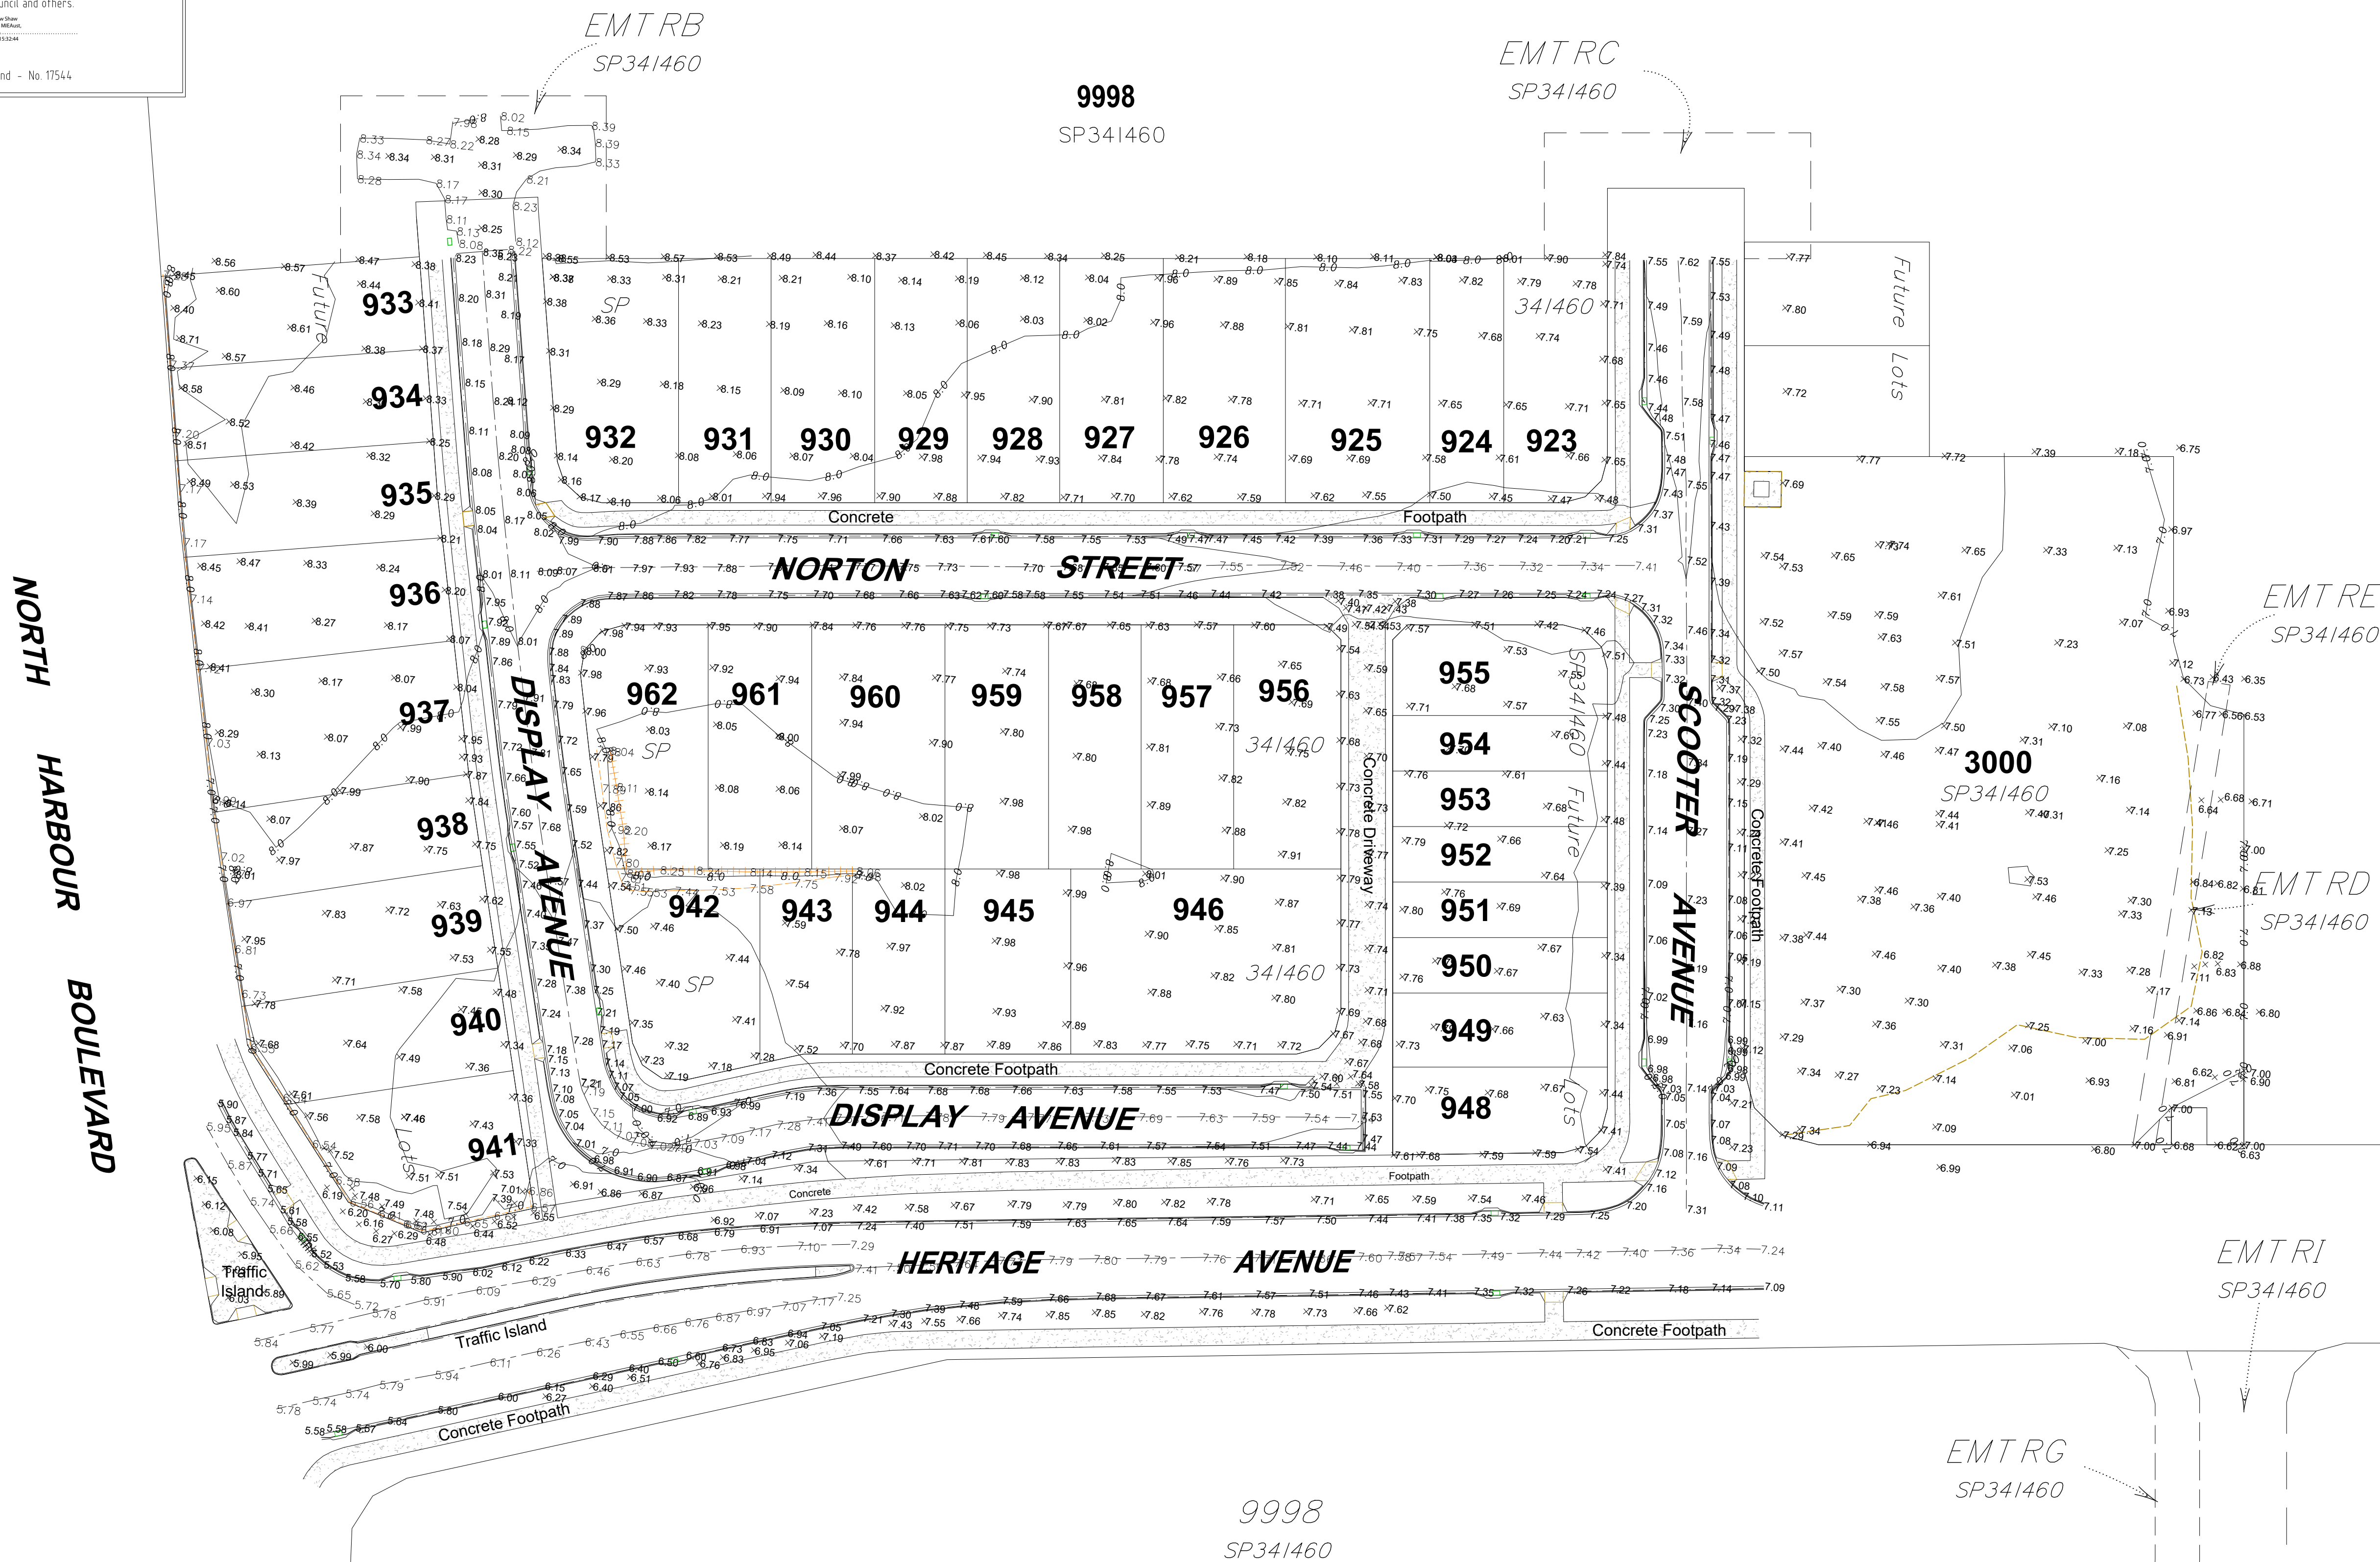

**SURVEYORS
PLANNERS
DEVELOPMENT ADVISORS**
jensenbowers.com.au

72 Costin Street, Fortitude Valley, Qld. 4006
PO Box 799, Spring Hill, Qld. 4004
T (07) 3852 1771 F (07) 3252 9818

T.H. Jensen & Bowers Pty. Ltd. (Consulting Surveyors)
ABN. 52 010 872 607

Copyright reserved to Jensen Bowers Group Consultants Pty Ltd


Associated Consultants

KN ENGINEERS P/L

Local Authority: Moreton Bay City Council
Authority Ref. No: DA/2023/4299
RP Description: SP341460

Locality: Morayfield
Date of Survey: 13/06/2025
Level Datum: AHD (der)
Origin: OPM 103504 (RL19.282)
Level Bk / Fid Bk: Digital
Horizontal Datum: MGA 2020 / Z56
Contour Interval: N/A

1:500 @ A1

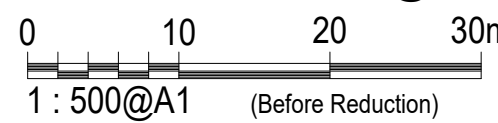

Any licence, expressed or implied, to use this document for any purpose whatsoever is restricted to the terms of the agreement or implied agreement between Jensen Bowers and the instructing party.

Drawn: AJ	Date: 01/07/2025
Surveyed: AJ	Date: 13/06/2025
Checked: SJM	Date: 01/07/2025

SJM

Description		Date	Appd.
A	Original Issue	01/07/25	SJM

NORTH HARBOUR HOLDINGS P/L

North Harbour Residential Stage 3A + 3B

**As Constructed
Finished Surface**

S-7550-003	Issue A	Original Size A1
------------	------------	---------------------