

ENGINEER'S CERTIFICATION

I, MARK SHAW being a certified / registered engineer and duly authorised representative of KN GROUP PTY LTD hereby:

- Certify the information contained in the drawing is an accurate "AS CONSTRUCTED" representation of the works.
- Accept responsibility for the "AS CONSTRUCTED" information contained in this drawing.
- Acknowledge the "AS CONSTRUCTED" information contained in drawing may be relied on by Council and others.

Certification by _____ on _____

for KN GROUP PTY LTD.
Registered Professional Engineer of Queensland - No. 17544



REGISTERED SURVEYOR'S CERTIFICATION

We, T.H. JENSEN BOWERS PTY LTD, hereby certify that the vertical and horizontal locations and dimensions shown on this plan are a true and correct record and were located by survey.

T.H. Jensen Bowers
Registered Surveyor (sig) Reg. Surveyor No. 3756 Date: 09/03/2026

Legend

- Road Kerb Invert
- Bottom of Bank
- +++++ Top of Bank
- Change of Grade
- Retaining Wall
- Contour Major
- Contour Minor
- Fence Line
- Concrete Path
- Surface Level

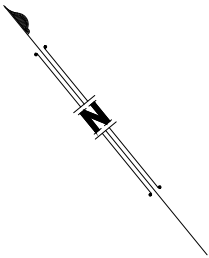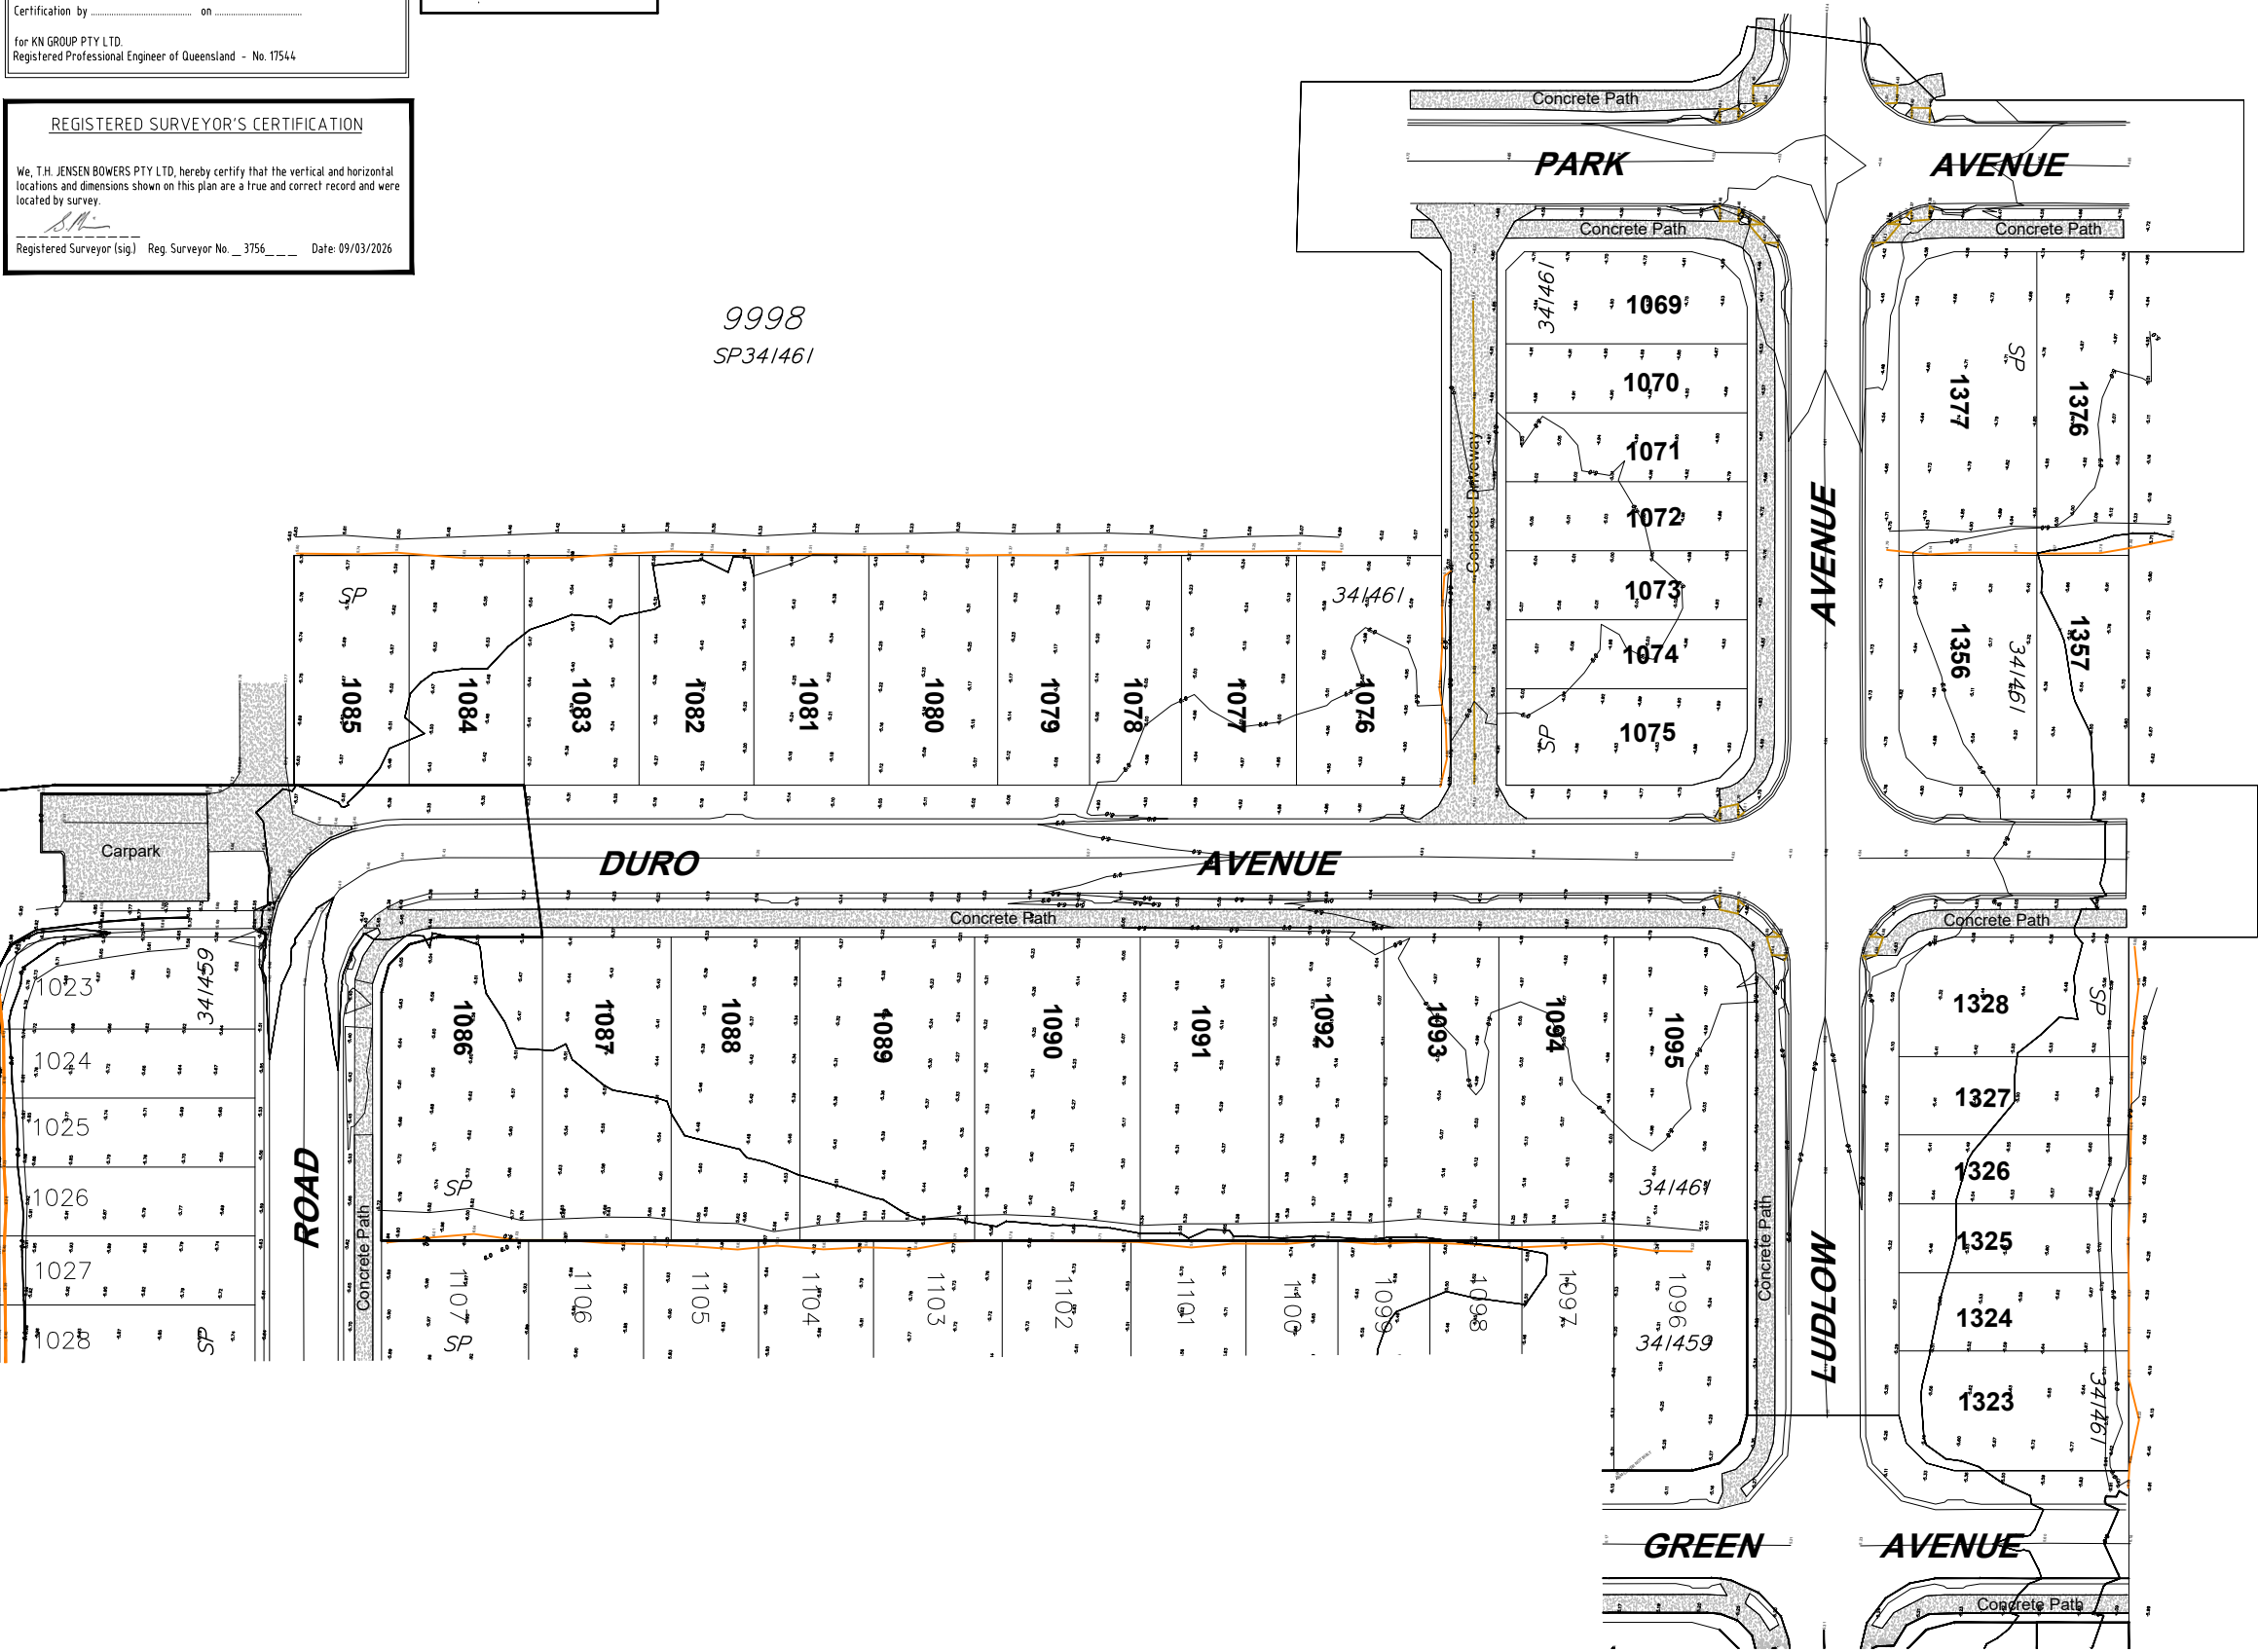

9998
SP341461

JENSEN BOWERS SURVEYORS PLANNERS DEVELOPMENT ADVISORS
jensenbowers.com.au

72 Costin Street, Fortitude Valley, Qld. 4006
PO Box 799, Spring Hill, Qld. 4004
T (07) 3852 1771 F (07) 3252 9818


T.H. Jensen & Bowers Pty. Ltd. (Consulting Surveyors)
ABN: 52 010 872 607

Copyright reserved to Jensen Bowers Group Consultants Pty Ltd

Associated Consultants
KN Engineers P/L

Local Authority: Moreton Bay City Council
Authority Ref. No: DA/2023/4299
RP Description: SP341461

Locality: Morayfield
Date of Survey: 10/02/2026
Level Datum: AHD (der)
Origin: OPM 103504 (RL19.282)
Level Bk / Fid Bk: Digital
Horizontal Datum: MGA 2020 / Z56
Contour Interval: N/A

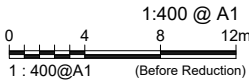

The levels shown have been located by field survey.

Any licence, expressed or implied, to use this document for any purpose whatsoever is restricted to the terms of the agreement or implied agreement between Jensen Bowers and the instructing party.

Drawn: AJ	Date: 09/03/2026
Surveyed: DB	Date: 20/02/2026
Checked: SJM	Date: 09/03/2026

SJM		
Description	Date	Appd.
A Original Issue	09/03/26	SJM

NORTH HARBOUR HOLDINGS P/L

North Harbour
Residential
Stage 4

As Constructed Finished Surface		
S-7550-610	Issue A	Original Size A1