


PSM 10354
E: 497116.520
N: 6998102.825
RL: 19.282m



UNITYWATER PROJECT NUMBER 2023023635-S1

STAGE 5 - North Harbour Residential North Estate

SEWER AND WATER MAIN AS CONSTRUCTED

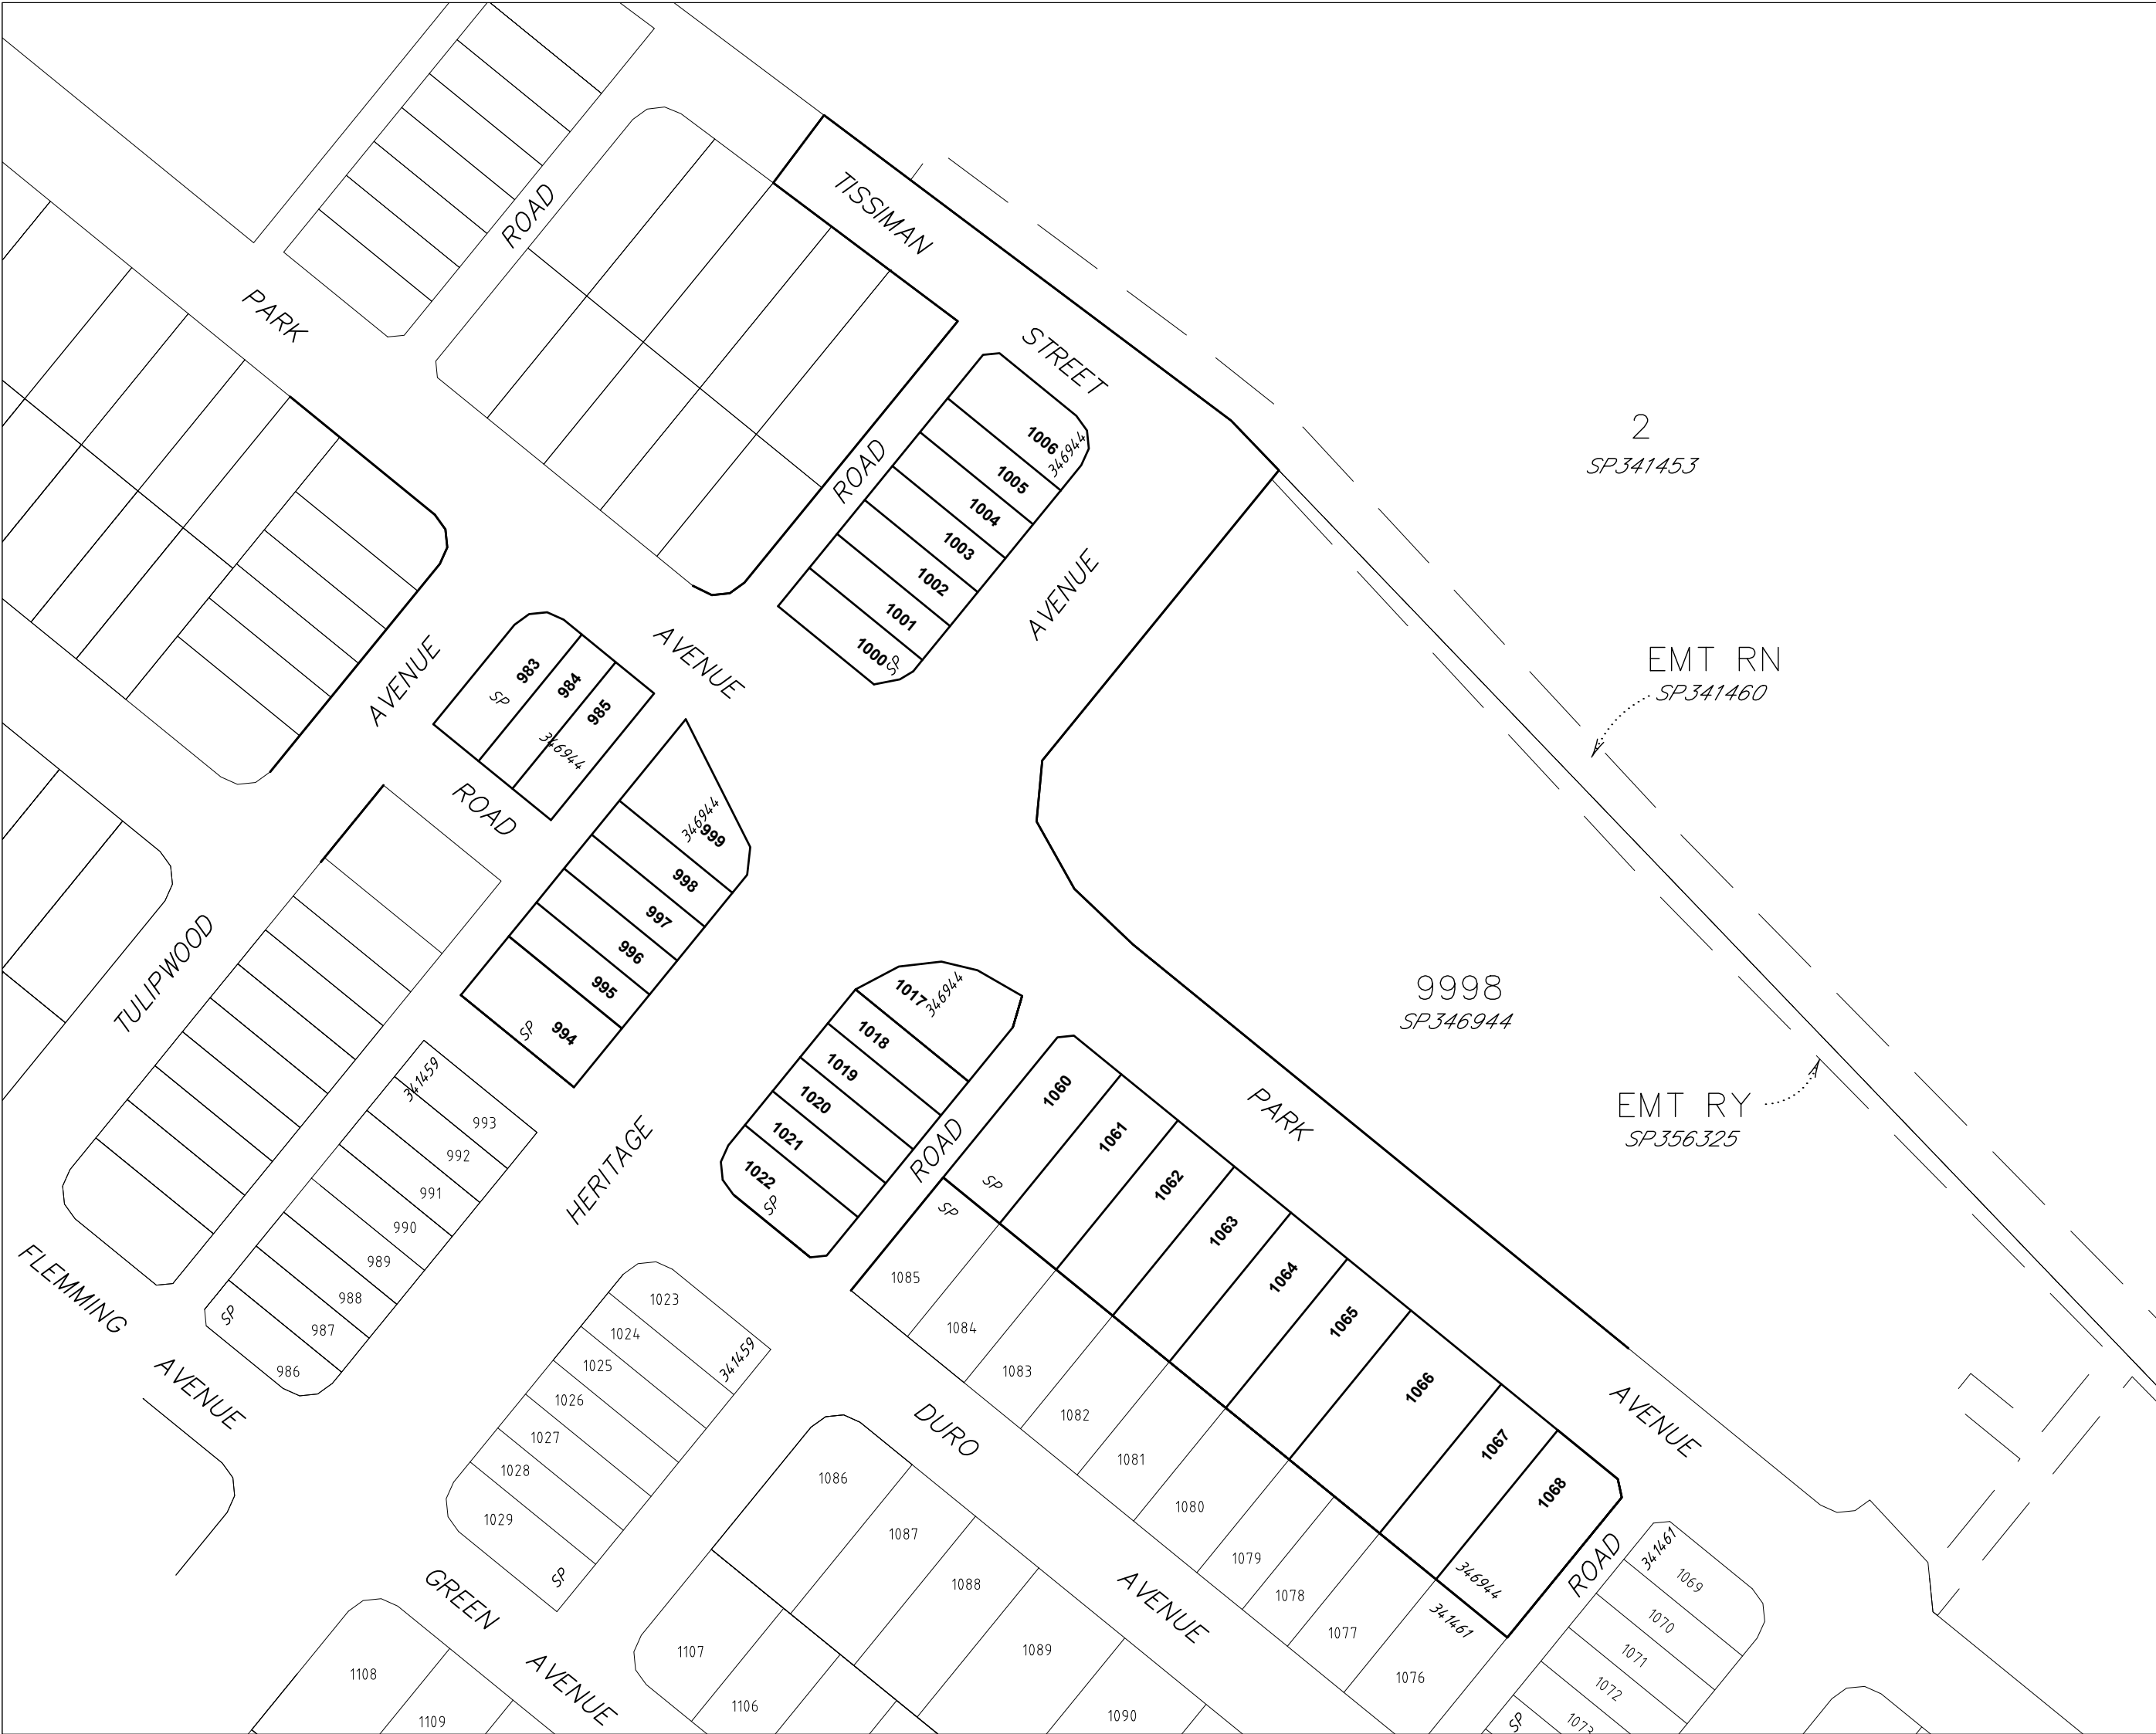

DRAWING INDEX	
DRAWING NUMBER	DESCRIPTION
U-2025-6155-1	LOCALITY PLAN AND DRAWING INDEX
U-2025-6155-2	SEWER AS CONSTRUCTED
U-2025-6155-3	WATER AS CONSTRUCTED

ENGINEER'S CERTIFICATION

Mark Shaw

- I, Mark Shaw, hereby certify that:
- The information contained in this drawing / document is in compliance with approved drawings and design.
 - The new water and sewerage works defined by this drawing have been designed and constructed in accordance with the SEQ Code.
 - This represents an accurate record of as-constructed works.
 - I accept responsibility for the information contained in this drawing / document.

Mark Shaw
RPEQ (Signature) RPEQ No. 17544 Date: 7/05/2026

REGISTERED SURVEYOR'S CERTIFICATION


Scott James Morrison

- I, Scott James Morrison, hereby certify that the vertical and horizontal locations and dimensions shown on this plan are a true and correct record and were located by survey.

Scott James Morrison
Registered Surveyor (sig) Reg. Surveyor No. 3756 Date: 07/05/2026

COORDINATE DATUM NOTE:

HORIZONTAL COORDINATES(E,N) SUPPLIED ARE MAPPING GRID OF AUSTRALIA(MGA), ZONE 56 BASED ON THE UNIVERSAL TRANSVERSE MERCATOR PROJECTION AND THE GEOCENTRIC DATUM OF AUSTRALIA 2020.

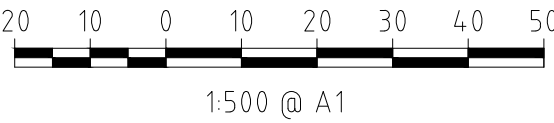

AS CONSTRUCTED

A1

INDEX	DATE	REVISIONS
A	29/02/2026	Original Issue

DRAWN	AJ	29/02/2026
CHECKED	SJM	29/02/2026
PASSED	SJM	29/02/2026
INITIALS		DATE



Unitywater

APP - 15150
North Harbour Stage 5


SHEET 1 OF 3	SHEETS	SCALE 1:500
REVISION DATE	29/02/2026	REVISION A
DISCIPLINE CODE	C	
DRAWING NO.	U-2025-6155	

LEGEND

- HCIL = House Connection Invert Level
- HCSSL = House Connection Surface Level
- SL = Surface Level
- SP = Survey Plan
- EMT = Easement
- MH = Manhole
- E = End

NOTES

- All pipes are 160 (SDR21) PE100 unless noted otherwise

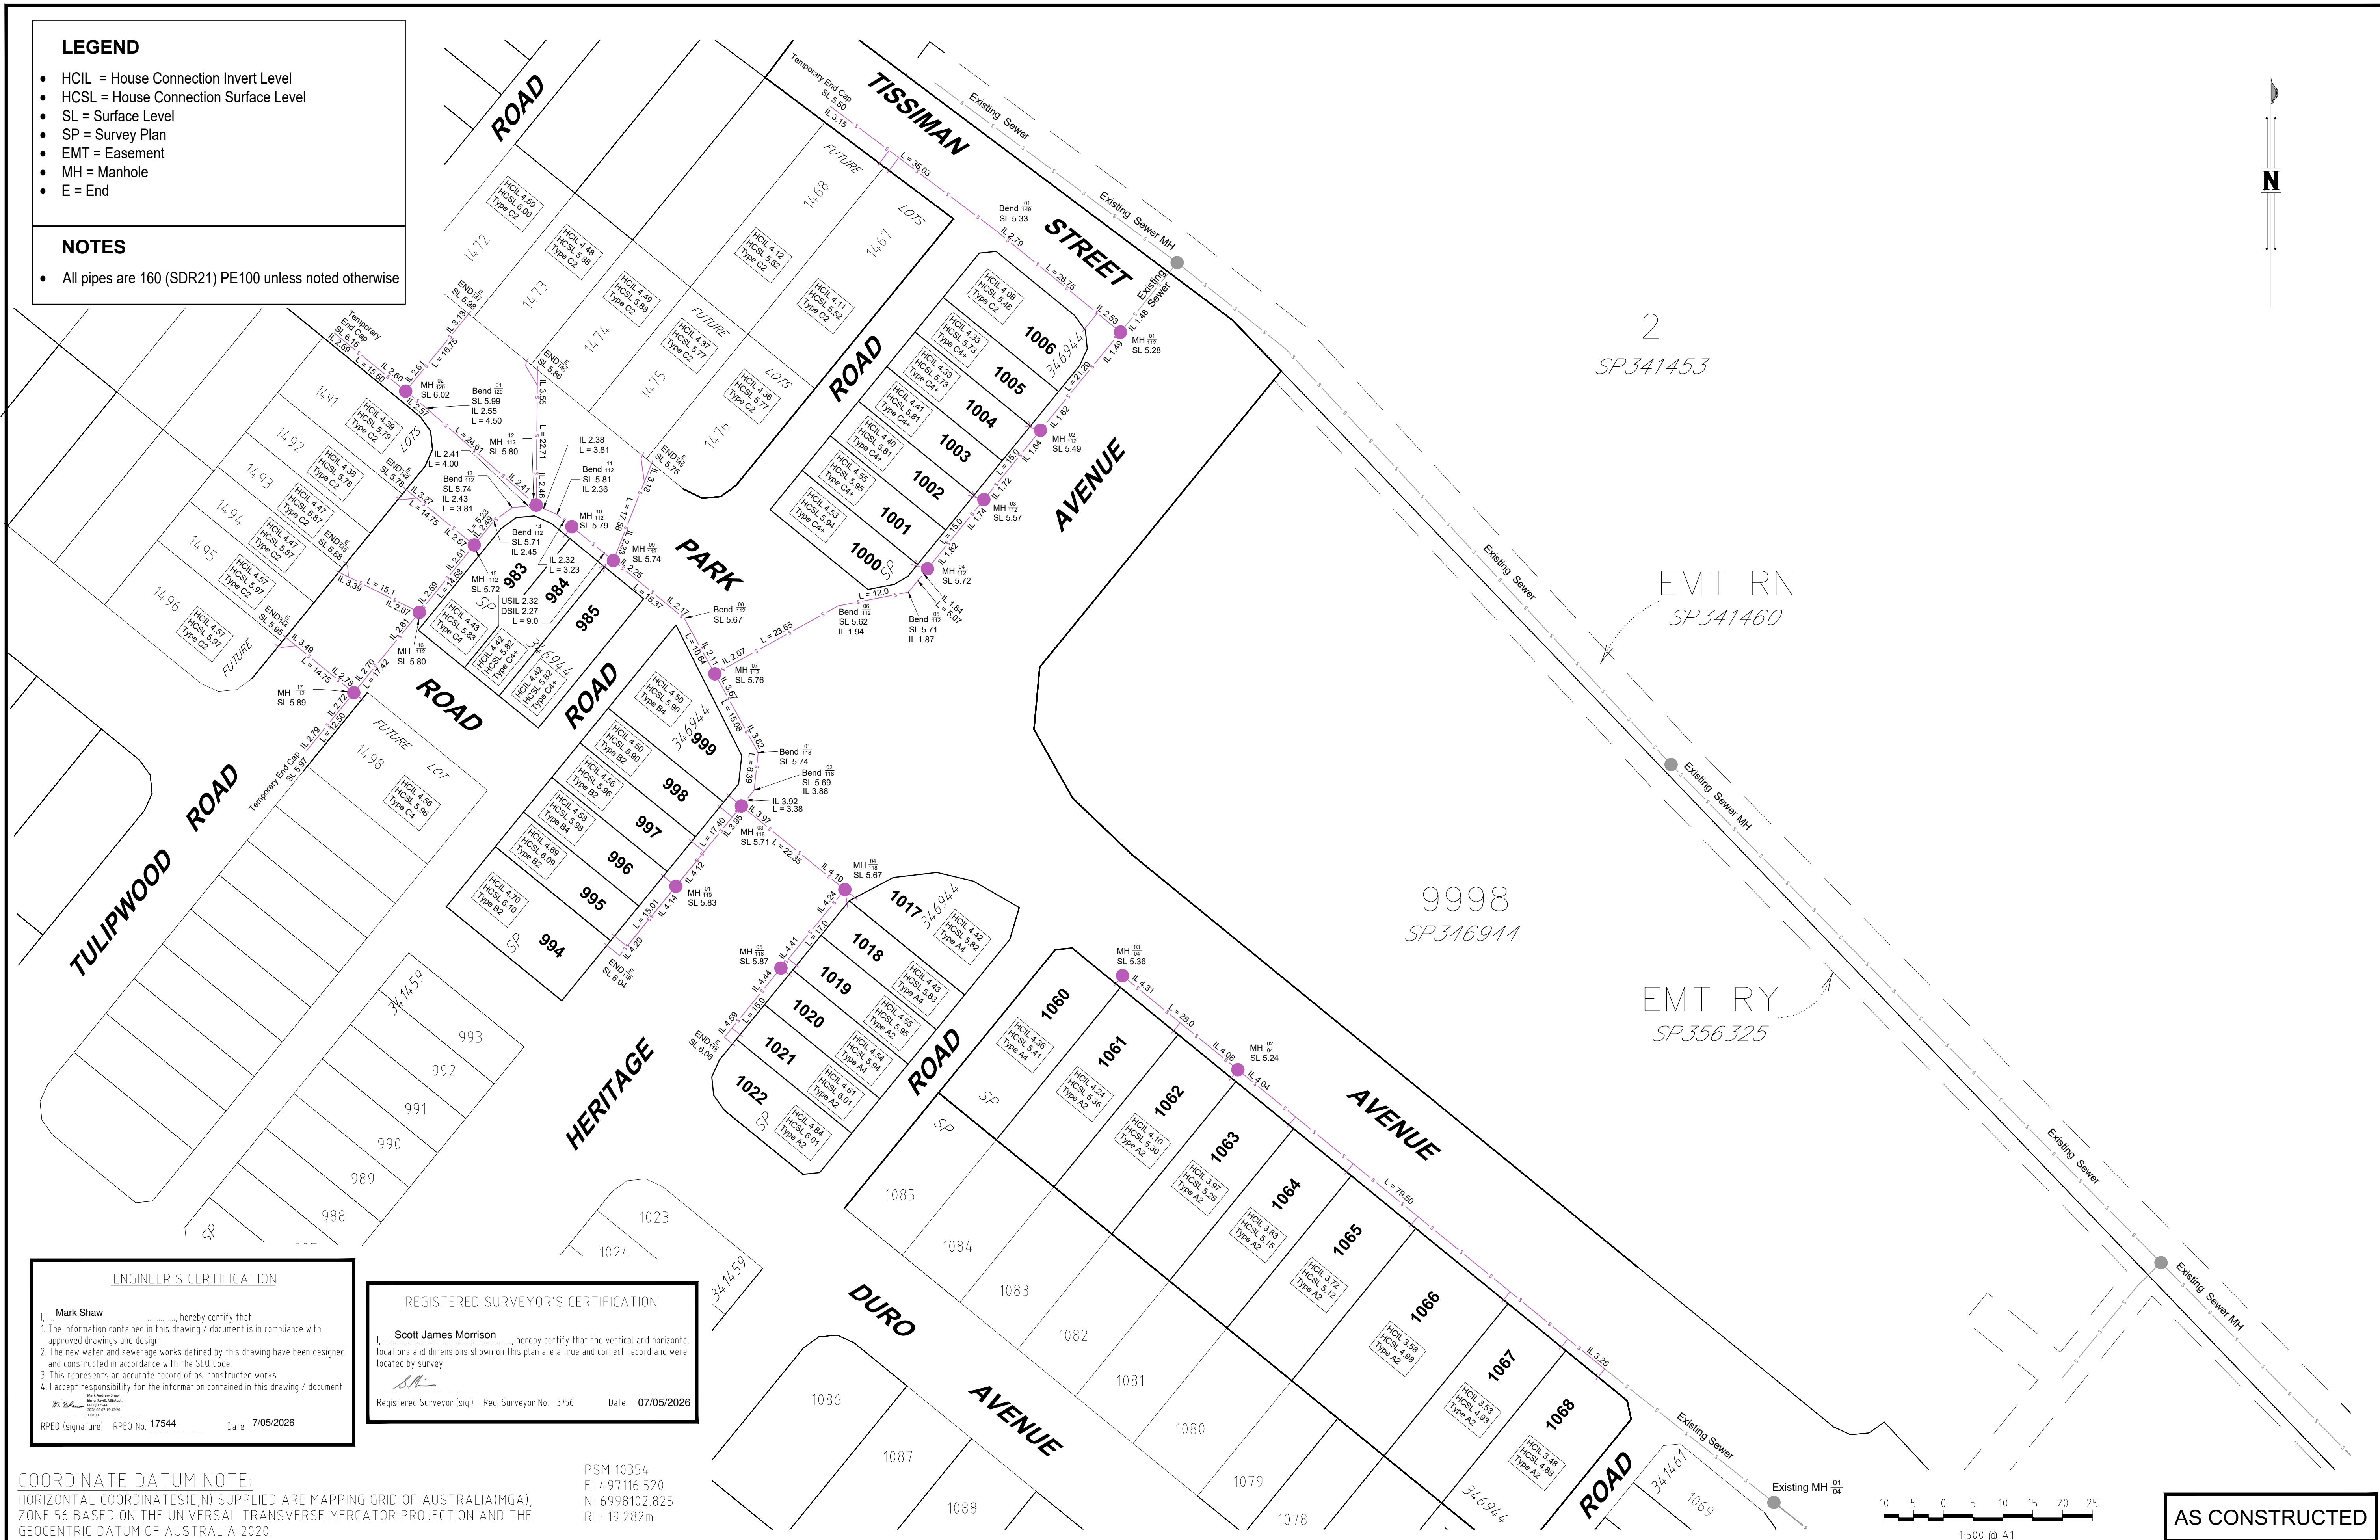

ENGINEER'S CERTIFICATION


I, **Mark Shaw**, hereby certify that:
1. The information contained in this drawing / document is in compliance with approved drawings and design.
2. The new water and sewerage works defined by this drawing have been designed and constructed in accordance with the SED Code.
3. This represents an accurate record of as-constructed works
4. I accept responsibility for the information contained in this drawing / document.
RPEQ (signature) RPEQ No. 17544 Date: 7/05/2026

REGISTERED SURVEYOR'S CERTIFICATION

I, **Scott James Morrison**, hereby certify that the vertical and horizontal locations and dimensions shown on this plan are a true and correct record and were located by survey.
Registered Surveyor (sig.) Reg. Surveyor No. 3756 Date: 07/05/2026

COORDINATE DATUM NOTE:
HORIZONTAL COORDINATES(E,N) SUPPLIED ARE MAPPING GRID OF AUSTRALIA(MGA), ZONE 56 BASED ON THE UNIVERSAL TRANSVERSE MERCATOR PROJECTION AND THE GEOCENTRIC DATUM OF AUSTRALIA 2020.

PSM 10354
E: 497116.520
N: 6998102.825
RL: 19.282m

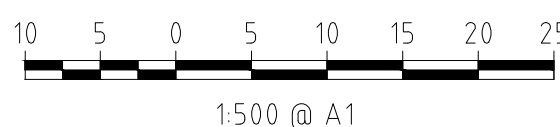

AS CONSTRUCTED

A1

INDEX	DATE	REVISIONS	DRAWN	CHECKED	PASSED
A	29/02/2026	Original Issue	AJ	SJM	SJM

DRAWN	AJ	29/02/2026
CHECKED	SJM	29/02/2026
PASSED	SJM	29/02/2026
INITIALS		DATE

JENSEN BOWERS
72 Costin Street, Portlouis Valley, Qld. 4006
PO Box 785, Spring Hill, Qld. 4004
T (07) 3852 1771 F (07) 3252 9818
JBA, SJM, RJS, RJS
T.J. Jensen & Bowers Pty. Ltd. (Consulting Surveyors)
JBA, SJM, RJS, RJS
© Copyright reserved to Jensen Bowers Group Consultants Pty Ltd
SURVEYORS
PLANNERS
DEVELOPMENT ADVISORS
jensenbowers.com.au



Unitywater

APP - 15150
North Harbour Stage 5

SHEET 2 OF 3 SHEETS	SCALE 1:500
REVISION DATE 29/02/2026	REVISION A
DISCIPLINE CODE C	
DRAWING NO. U-2025-6155	

