"I, MARK SHAW being a certified / registered engineer and duly authorised representative of KN GROUP PTY LTD hereby –

- × Certify the information contained in this drawing is an accurate "AS CONSTRUCTED" representation of the works.
- × Accept responsibility for the "AS CONSTRUCTED" information contained in this drawing.
- × Acknowledge the "AS CONSTRUCTED" information contained in the drawing may be relied on by Council and others.

Certification for Stage ..... by ..... on ..... ."

for KN GROUP PTY LTD.

Registered Professional Engineer of Queensland – No. 17544

We RPS Australia East Pty Ltd, Registered Surveyor – Land hereby certify that the Levels and Dimensions shown hereon are a correct record of our Survey which was performed in accordance with Council Accuracy Standards

Authorised Delegate

13/09/2017
Date

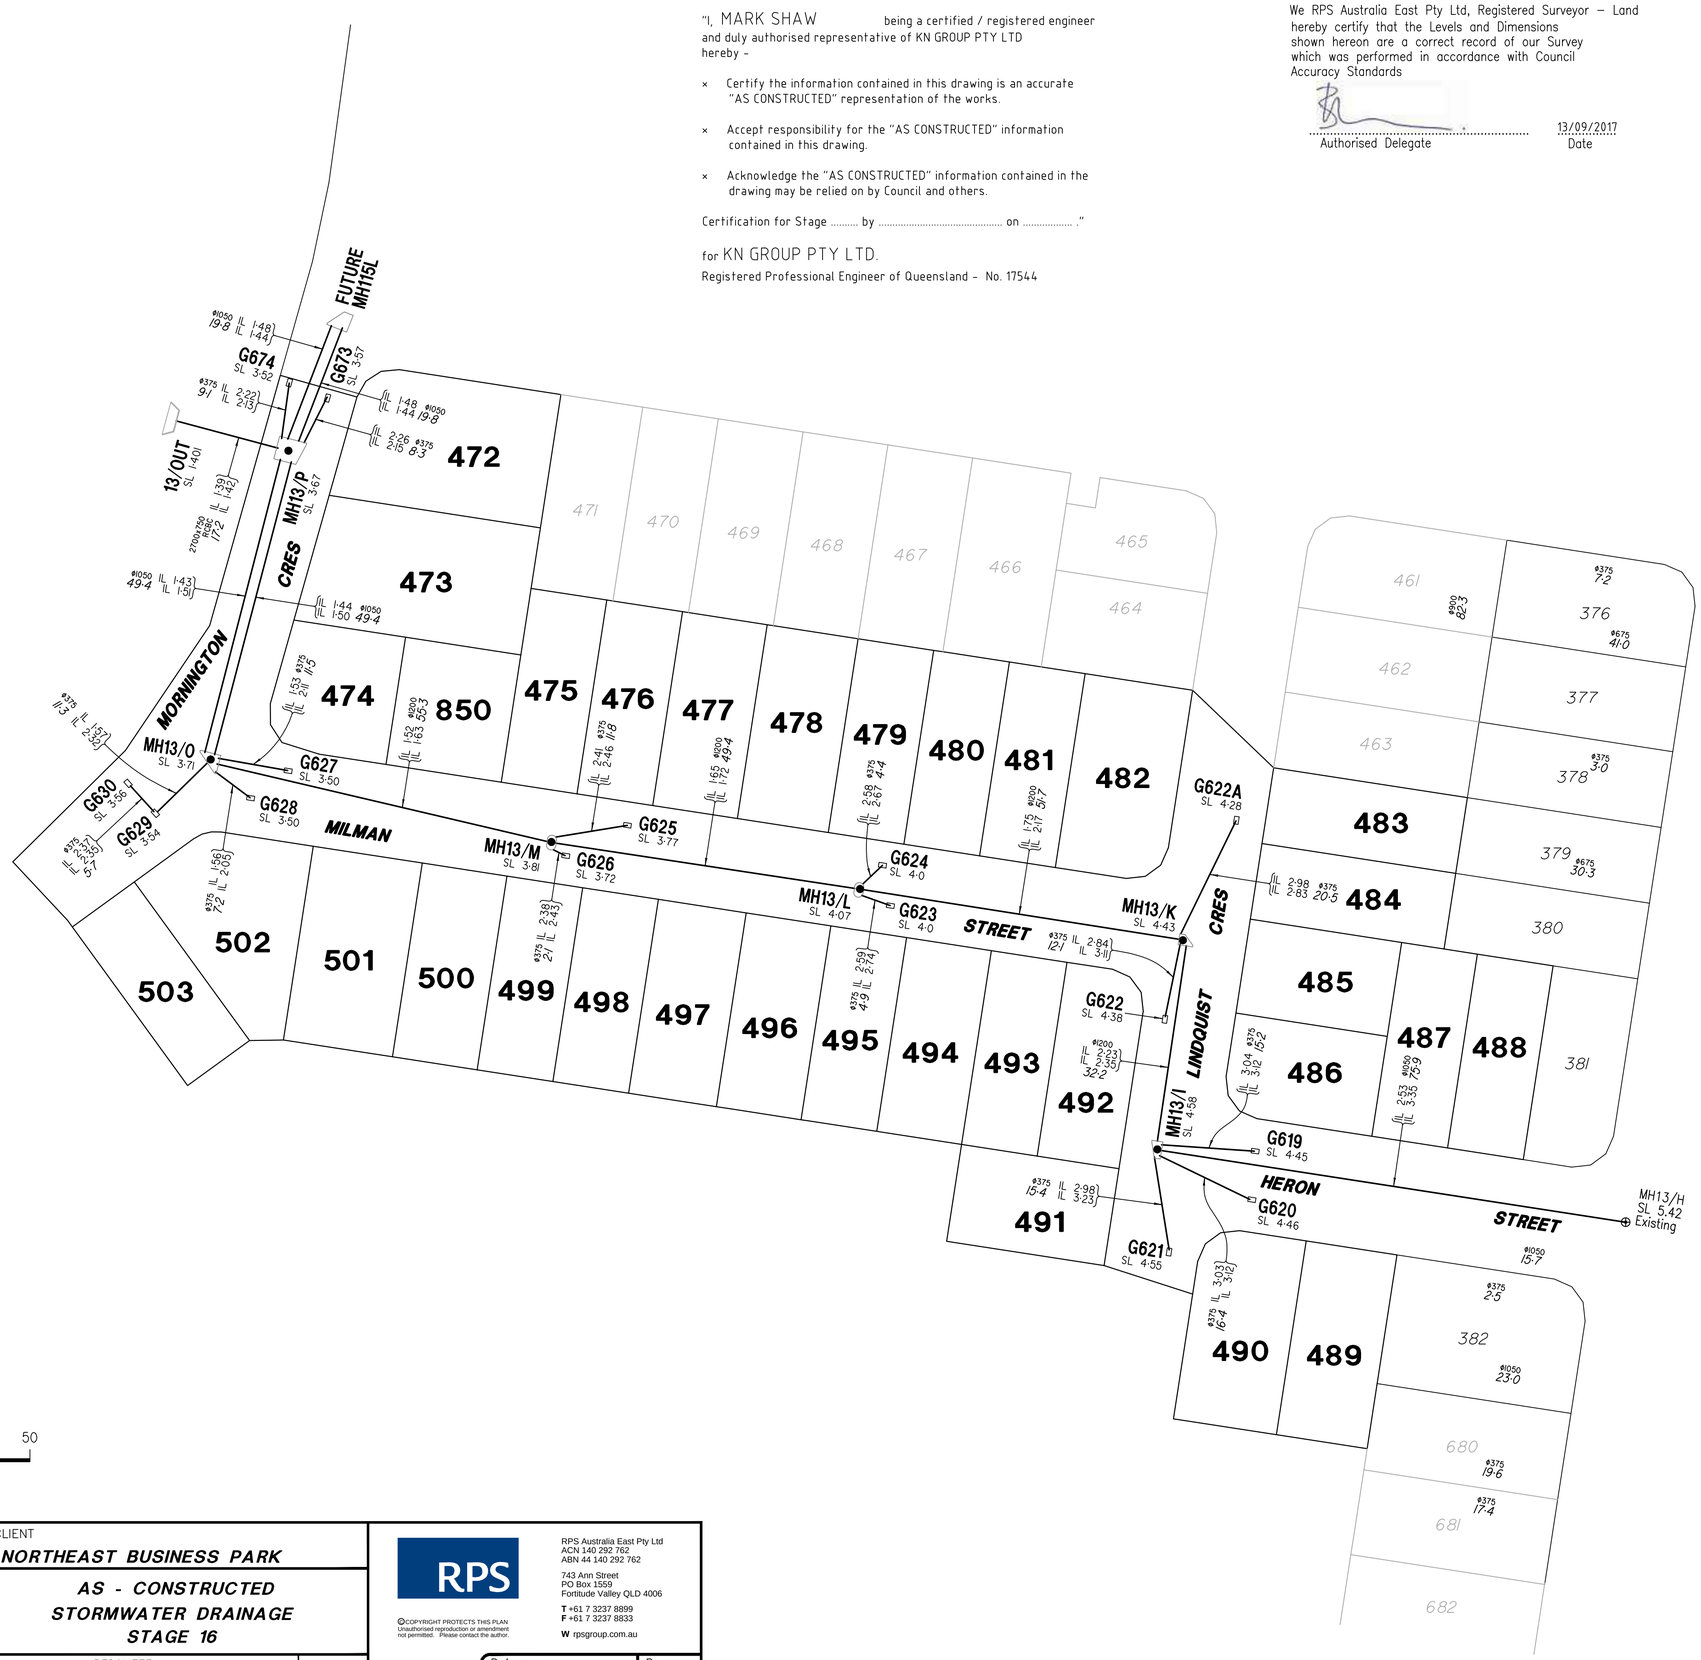

0 10 20 30 40 50

SCALE IN METRES

PROJECT: NORTH HARBOUR		CLIENT: NORTHEAST BUSINESS PARK	
LEVEL DATUM: AHD	SCALE: 1:500 @ A1	AS - CONSTRUCTED STORMWATER DRAINAGE STAGE 16	
ORIGIN: PM 72418 RL 14·859 CNR BUCKLEY & COBB RDS	Date: 2017		
	Surveyed: RPS		
FB : SDR LB :	Comp by: AJH/KCH	Parish: REDCLIFFE	Job Ref: 20430-SI6
	DWG Name: 20430-Stage16-Storm	Local Authority: MORETON BAY REGIONAL COUNCIL	

RPS Australia East Pty Ltd
ACN 140 292 762
ABN 44 140 292 762

743 Ann Street
PO Box 1559
Fortitude Valley QLD 4006

T +61 7 3237 8899
F +61 7 3237 8833

W rpsgroup.com.au

©COPYRIGHT PROTECTS THIS PLAN
Unauthorised reproduction or amendment not permitted. Please contact the author.

Reference: 20430-202

Rev: