LEGEND

Ø	Pipe Diameter
L	Length
IL	Invert Level
SL	Surface Level
MH	Manhole
USIL	Up Stream Invert Level
DSIL	Down Stream Invert Level
▭	Gully Pit

ENGINEER'S CERTIFICATION

I, MARK SHAW being a certified / registered engineer and duly authorised representative of KN GROUP PTY LTD hereby:

- Certify the information contained in the drawing is an accurate "AS CONSTRUCTED" representation of the works.
- Accept responsibility for the "AS CONSTRUCTED" information contained in this drawing.
- Acknowledge the "AS CONSTRUCTED" information contained in drawing may be relied on by Council and others.

Certification by ..... Mark Andrew Shaw BEng (Civil), MIEAust, APEQ 17544 2026.05.06 11:51:09 +10'00'

for KN GROUP PTY LTD.
Registered Professional Engineer of Queensland - No. 17544

REGISTERED SURVEYOR'S CERTIFICATION

We, T.H. JENSEN BOWERS PTY LTD, hereby certify that the vertical and horizontal locations and dimensions shown on this plan are a true and correct record and were located by survey.

Registered Surveyor (sig.) Reg. Surveyor No. 3756 Date: 20/02/2026

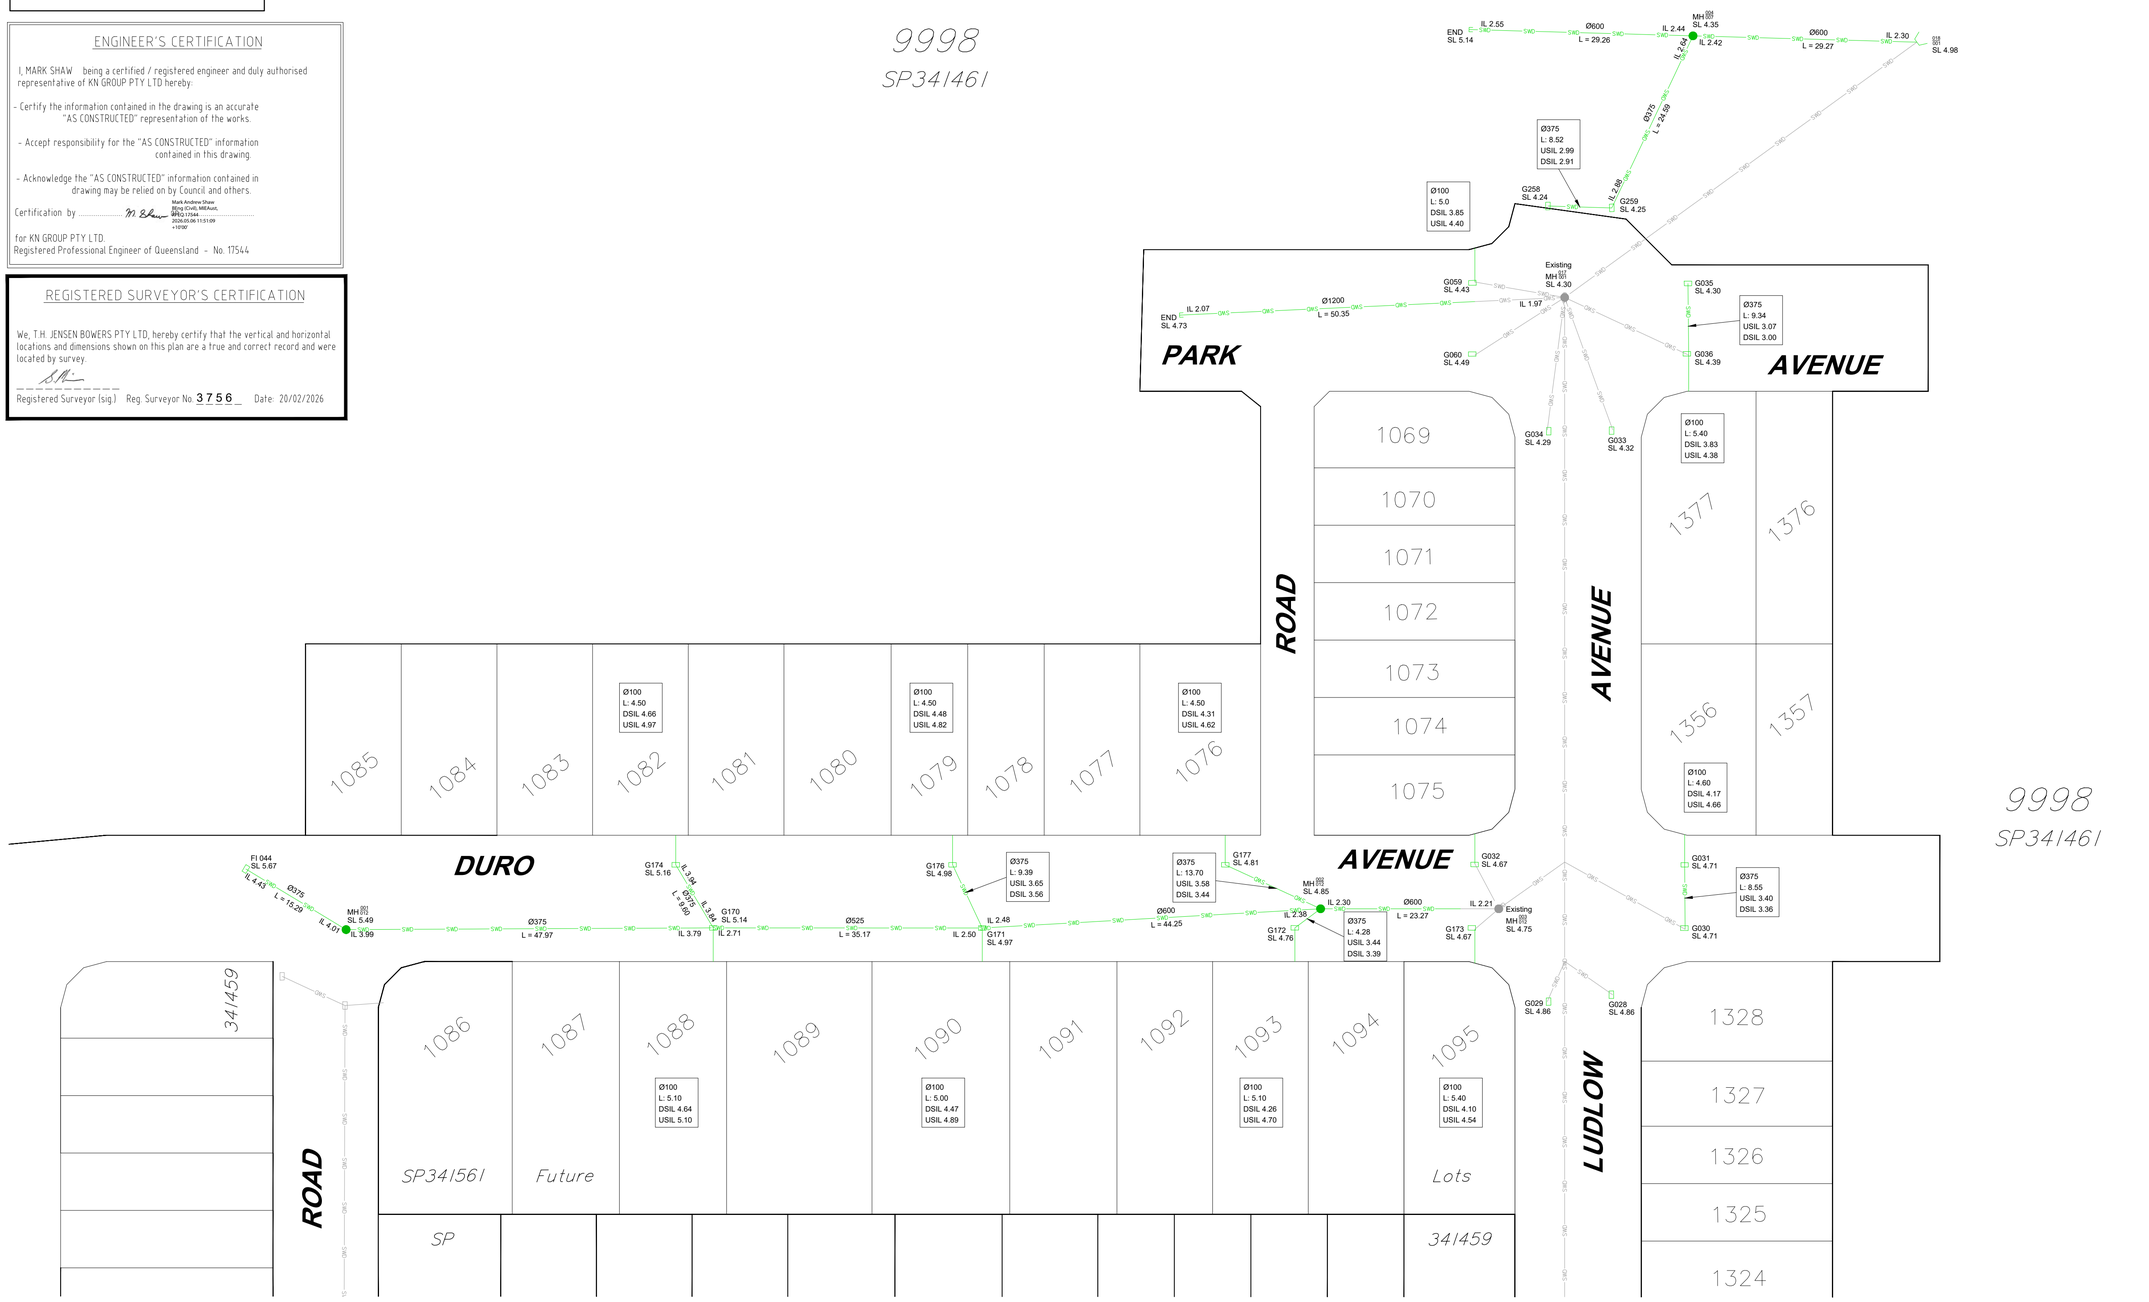

JENSEN BOWERS
SURVEYORS PLANNERS DEVELOPMENT ADVISORS
jensenbowers.com.au

72 Costin Street, Fortitude Valley, Qld. 4006
PO Box 799, Spring Hill, Qld. 4004
T (07) 3852 1771 **F** (07) 3252 9818

T.H. Jensen & Bowers Pty. Ltd. (Consulting Surveyors)
ABN. 52 010 872 607

© Copyright reserved to Jensen Bowers Group Consultants Pty Ltd

Associated Consultants

KN Engineers P/L

Local Authority: Moreton Bay City Council
Authority Ref. No: DA/2023/4299
RP Description: SP341459

Locality : Morayfield
Date of Survey: 13/01/2026
Level Datum: AHD (der)
Origin: OPM 103504 (RL19.282)
Level Bk / Fld Bk: Digital
Horizontal Datum: MGA 2020 / Z56
Contour Interval: N/A

Scale

1:400 @ A1
0 4 8 12m
1 : 400@A1 (Before Reduction)

The services shown hereon have been located by field survey.

Disclaimer

Any licence, expressed or implied, to use this document for any purpose whatsoever is restricted to the terms of the agreement or implied agreement between Jensen Bowers and the instructing party.

Drawn:	AJ	Date:	15/01/2026
Surveyed:	DB	Date:	13/01/2026
Checked:	SJM	Date:	15/01/2026
Approved:	SJM		

Issue	Description	Date	Appd.
A	Original Issue	15/01/26	SJM
B	Roofwater House Connections Added	20/02/26	SJM

Client

NORTH HARBOUR HOLDINGS P/L

North Harbour Residential Stage 4

As Constructed Stormwater

Drawing No.	Issue	Original Size
S-7550-608	B	A1